

#2403

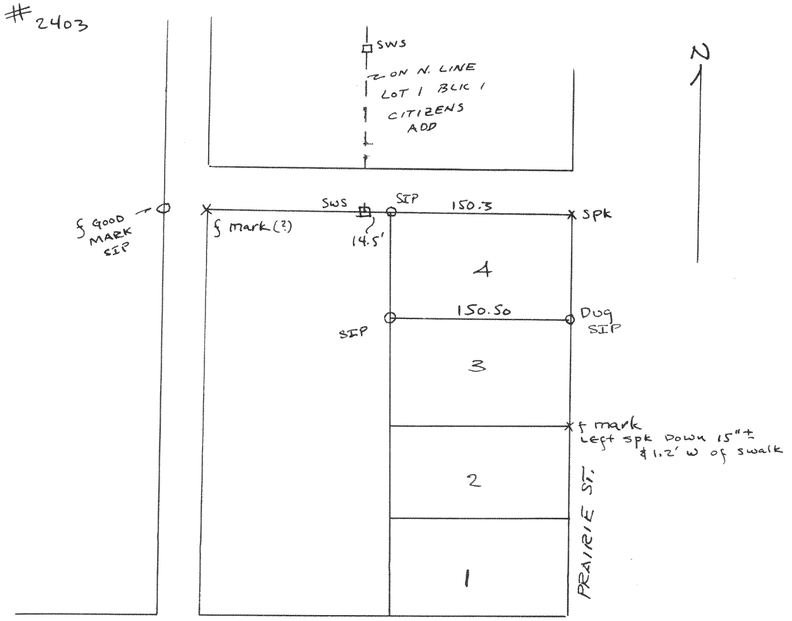

Plat of survey of S. line of lot 4, Brigham add. to Village of Sharon, Walworth County, Wisconsin
May 14, 1951

Lloyd S. Jensen JEB
County Surveyor


#2404

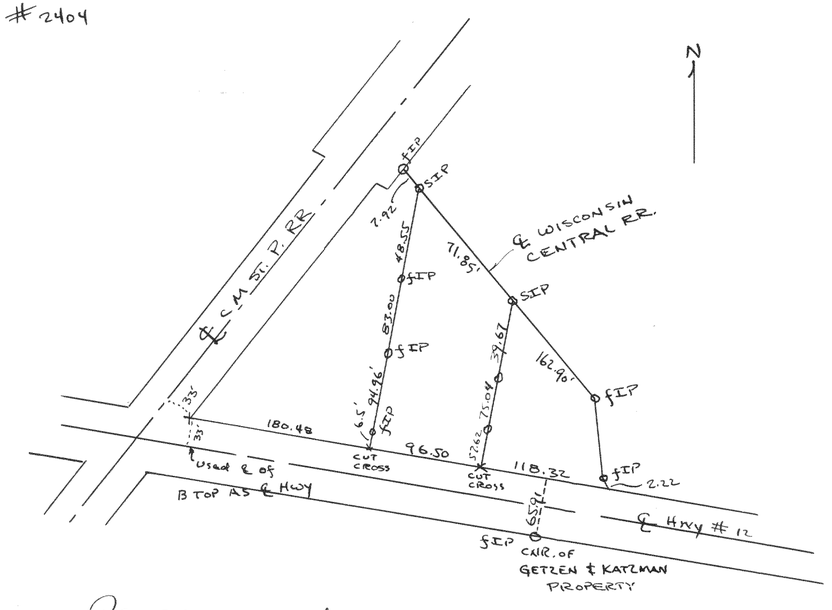

Plat of survey of Filling Station property located on lot 7, Blk. 5 arnolds add. City of Elkhorn, Walworth County, Wisconsin
March 28, 1951

Lloyd S. Jensen JEB
County Surveyor

#2405

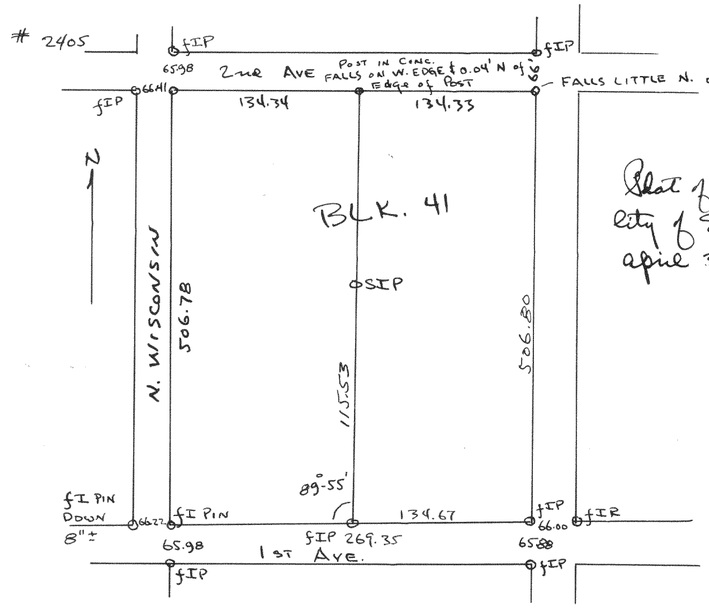

Plat of survey of part of Blk. 41, Arnolds add. City of Elkhorn, Walworth County, Wis.
April 30, 1951

Lloyd S. Jensen JEB
County Surveyor