#2403

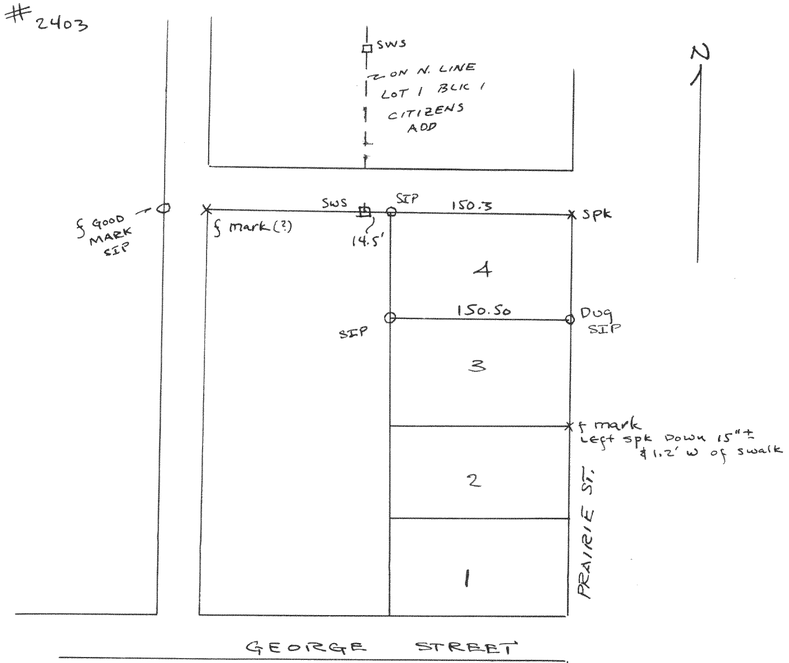

Plat of survey of S. line of lots 4, Brigham add.
The Village of Sharon, Walworth County, Wisconsin
May 14, 1951

Floyd S. Jensen JEB
County Surveyor

#2404

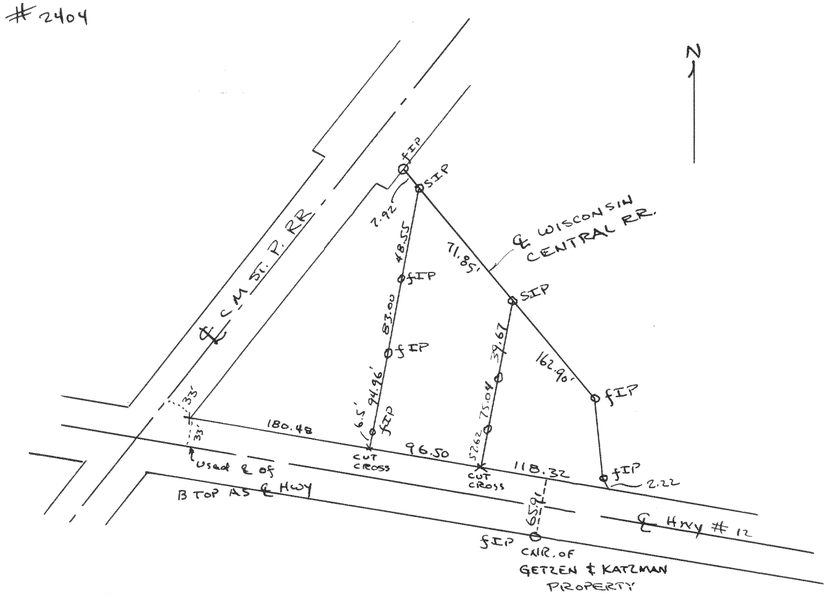

Plat of survey of Filling Station property located on lot 7, Blk. 5 arnolds add.
City of Elkhorn, Walworth County, Wisconsin
March 28, 1951

Floyd S. Jensen JEB
County Surveyor

#2405

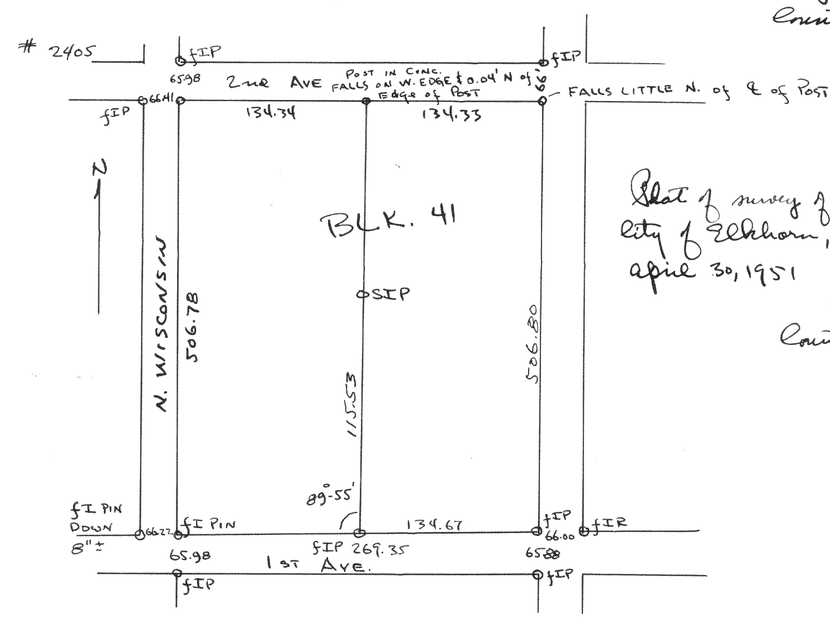

Plat of survey of part of Blk. 41, Davis add.
City of Elkhorn, Walworth County, Wis.
April 30, 1951

Floyd S. Jensen JEB
County Surveyor