
#2406

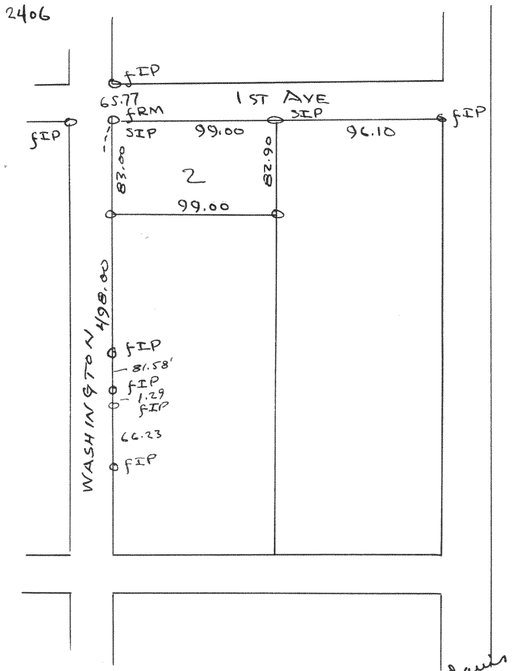


Plat of survey of Lot 2, Blk 35, City of Elkhorn, Walworth County, Wisconsin
Aug. 25, 1951

Davis add

Lloyd L Jensen RLS
County Surveyor


#2406½

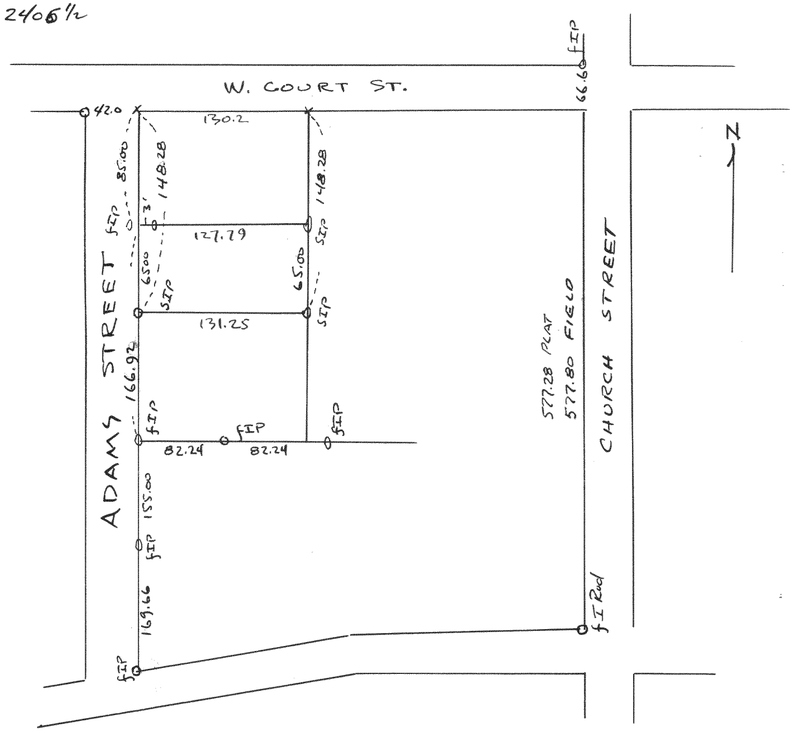

Plat of survey of Burns Property located on Adams Street in the SE 1/4 of Sec 36 T3N R16E, City of Elkhorn, Walworth County, Wisconsin
Aug. 1958

Lloyd L. Jensen RLS
County Surveyor

2407
#2406

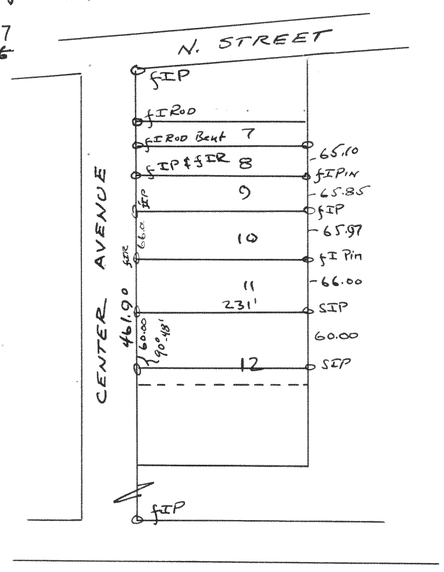

Plat of survey of the N 60' of Lot 12, Blk 2 North View Add., Village of East Troy
May 12, 1951

Lloyd L. Jensen RLS
County Surveyor