

#2409

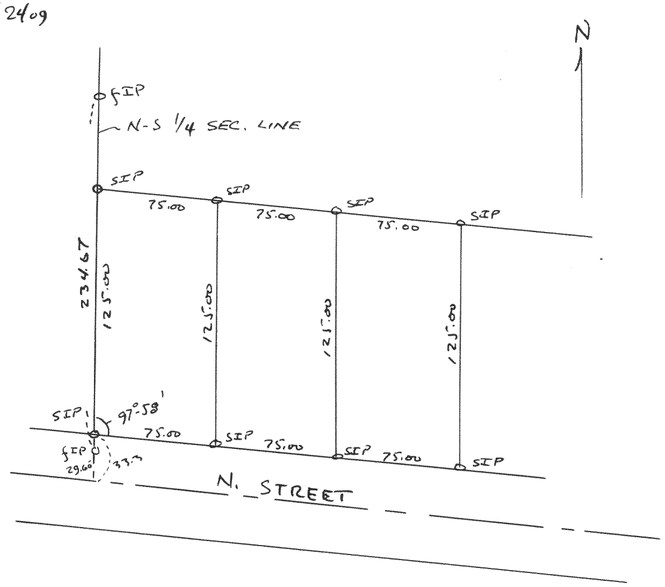

Plat of survey of parcels of land located on the City Dump Property in the SE 1/4 of Sec 19, T4N R18E, Village of East Troy, Walworth County, Wisconsin
July 28, 1951

Lloyd L. Jensen RLS
County Surveyor


#2410

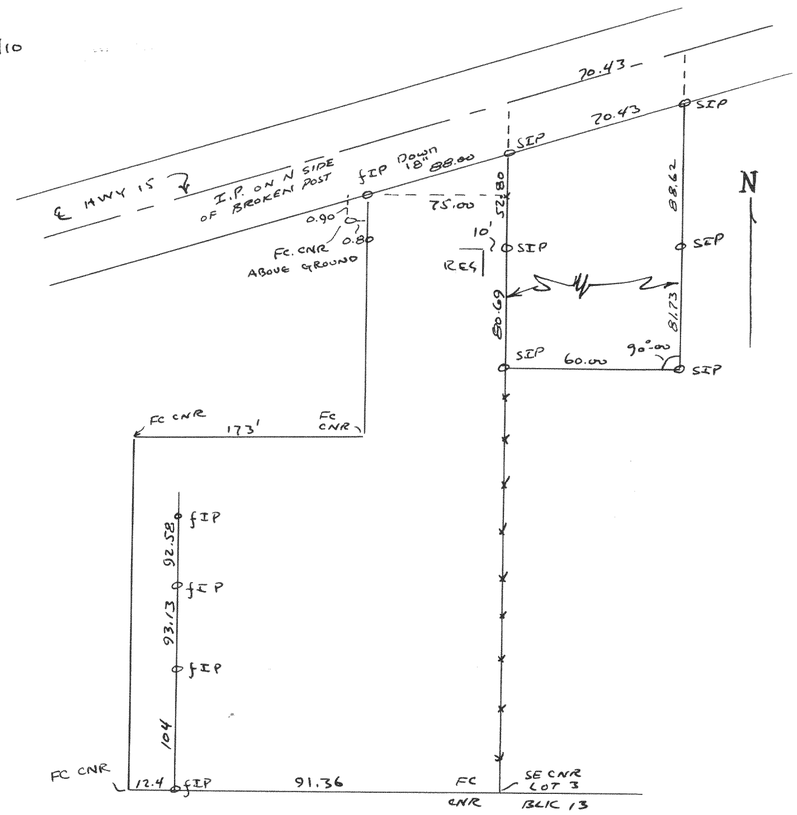

Plat of survey of a parcel of land for Robrian located in the SW 1/4 of Section 20 T4N R18E Village of East Troy Walworth County, Wisconsin
Sept. 10, 1951

Lloyd L. Jensen RLS
County Surveyor

#2411

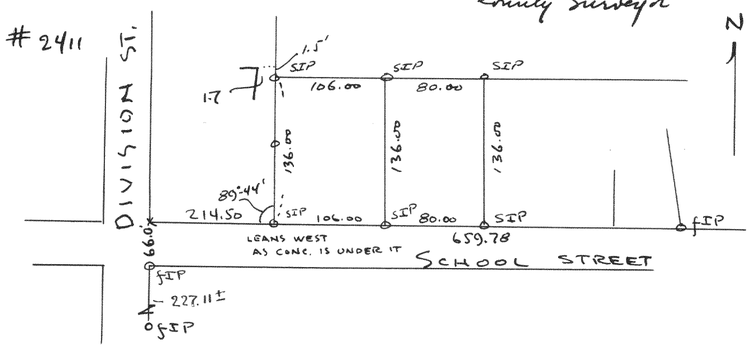

Plat of survey of land located on Lot 4, Block 1, Original Plat, Village of East Troy, Walworth County, Wisconsin
Sept 12, 1951

Lloyd L. Jensen RLS
County Surveyor