

#2414

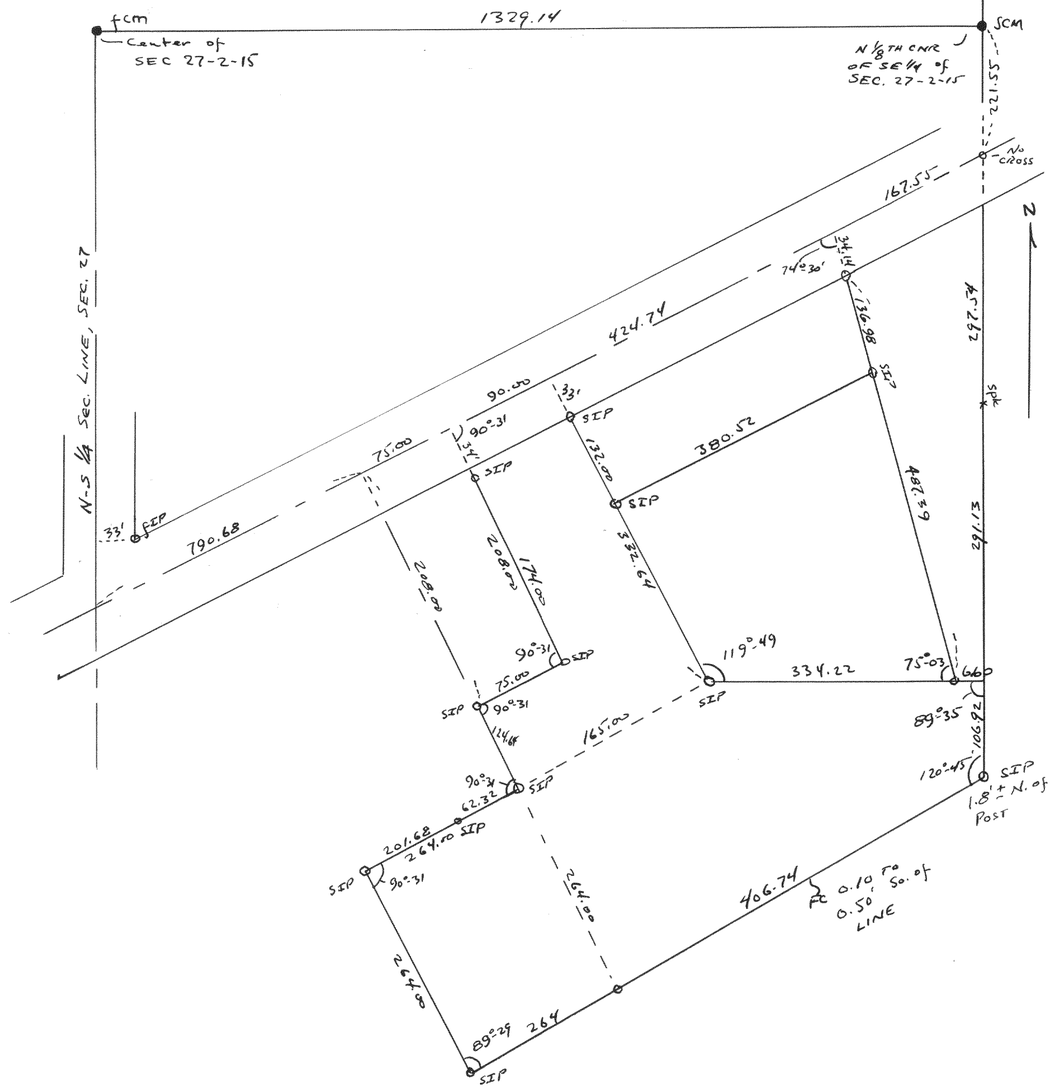

Plat of survey of the Huber Estates located in the SE 1/4 of Sec 27-2-15
Village of Darien, Walworth County, Wisconsin
Nov. 1951

Lloyd L. Jensen jcs
County Surveyor

#2415

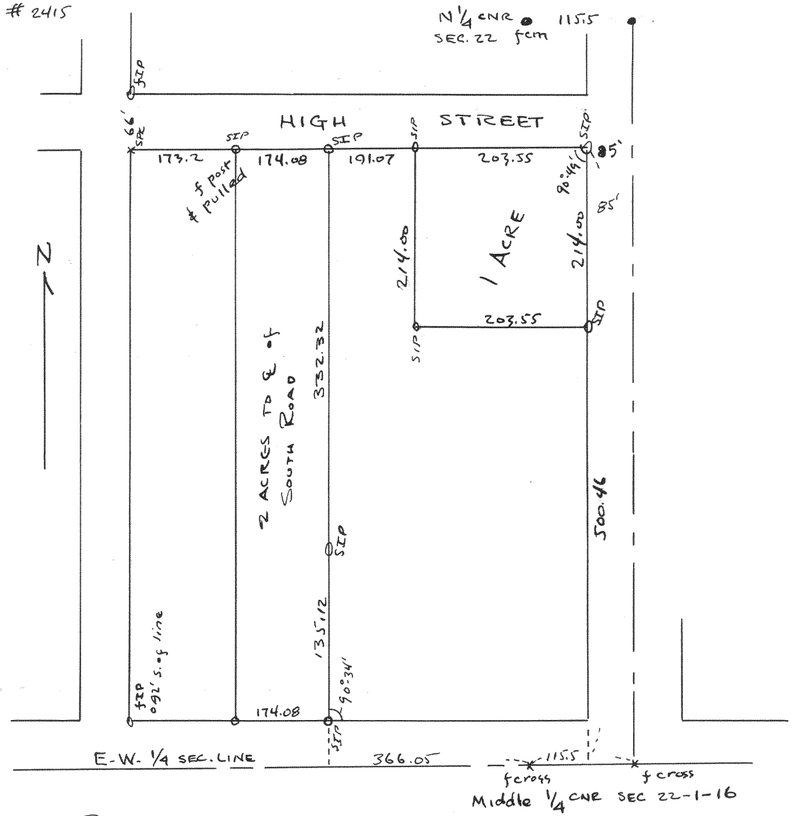

Plat of survey of 1 acre and 2 acre parcel of land for Cyprys in the N 1/2 of Section 22, T1N R16E, Village of Walworth, Walworth County, Wisconsin
1951

Lloyd L. Jensen jcs
County Surveyor