2416

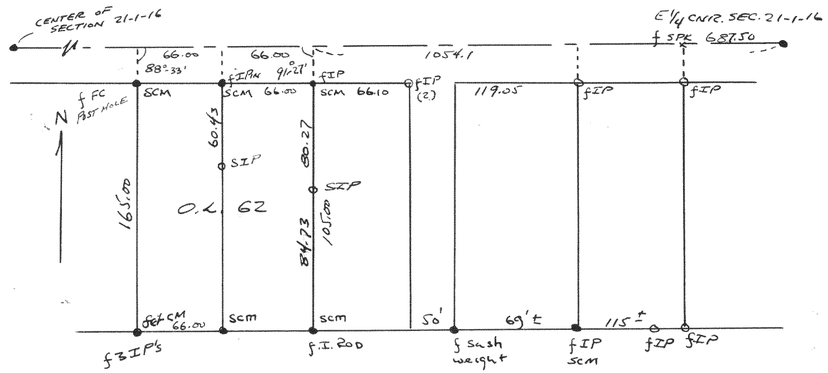

Plat of survey & division of O.L. 62 in SE 1/4 of Sec 21-1-16
Village of Walworth, Walworth County, Wisconsin
May 1, 1951

Floyd S. Jensen (QRB)
County Surveyor

2417

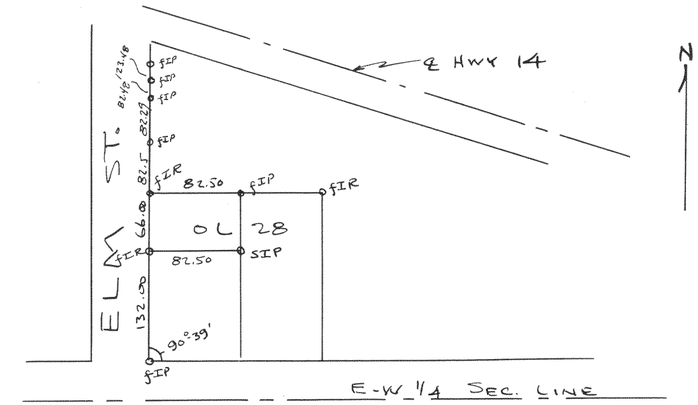

Plat of survey of part of O.L. 28 in NE 1/4 of Sec 21, T1N R16E
Village of Walworth, Walworth County, Wisconsin
May 14, 1951

Floyd S. Jensen QRB
County Surveyor

2418

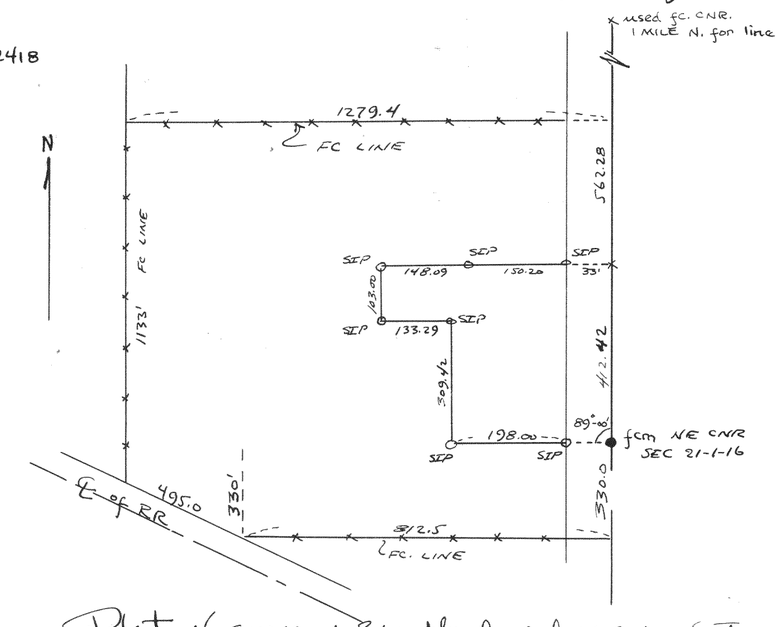

Plat of survey of Brieschke land located in Sections 21 & 16
T1N R16E, Walworth County, Wisconsin

Floyd S. Jensen QRB
County Surveyor

1951

2419

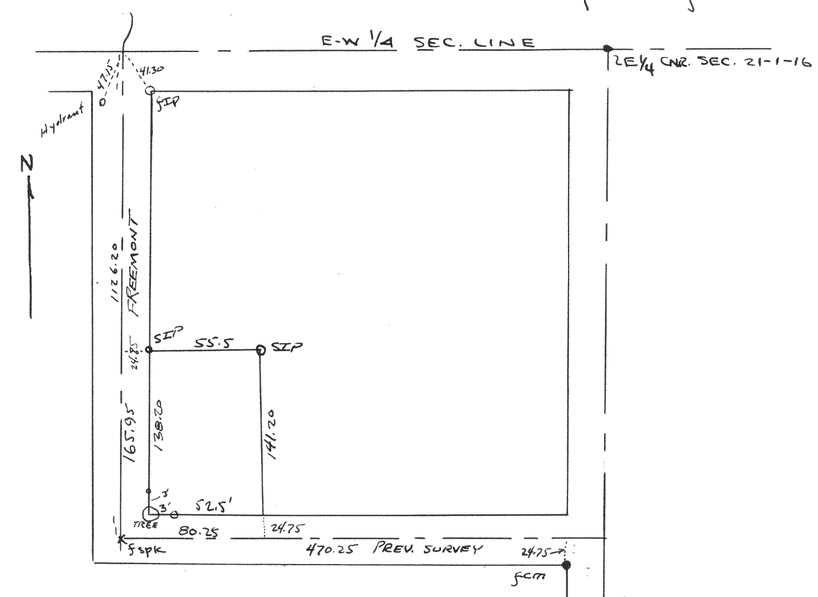

Plat of survey of lot 19 (except the East 60 ft.) of
Phillips Add., Village of Walworth, Walworth County, Wis.
Oct 4, 1951

Floyd S. Jensen QRB
County Surveyor