

2416

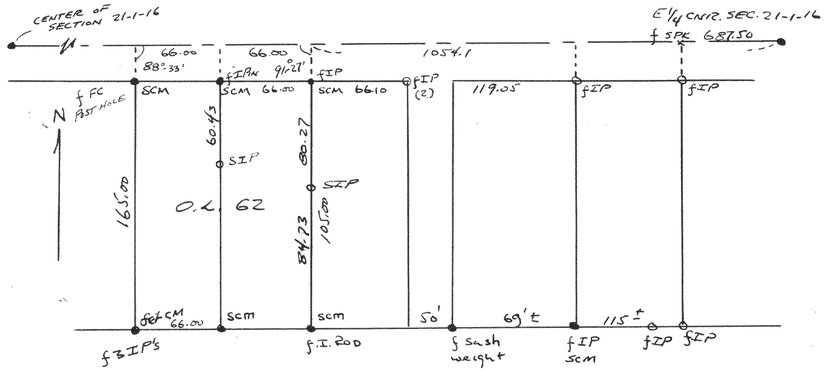

Plat of survey & division of O.L. 62 in SE 1/4 of Sec 21-1-16
Village of Walworth, Walworth County, Wisconsin
May 1, 1951

Lloyd S. Jensen (QRB)
County Surveyor


2417

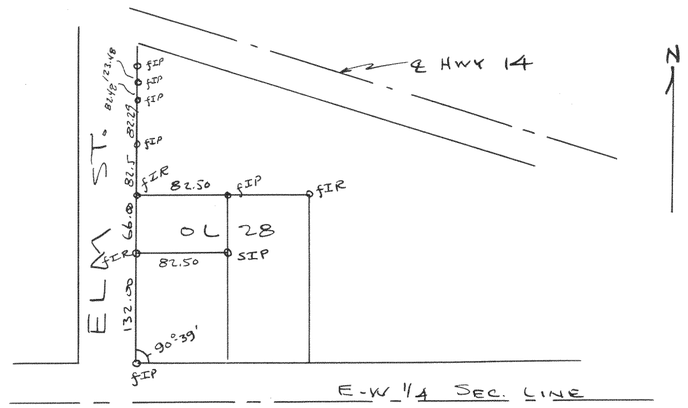

Plat of survey & part of O.L. 28 in NE 1/4 of Sec 21, T1N R16E
Village of Walworth, Walworth County, Wisconsin
May 14, 1951

Lloyd S. Jensen QRB
County Surveyor

2418

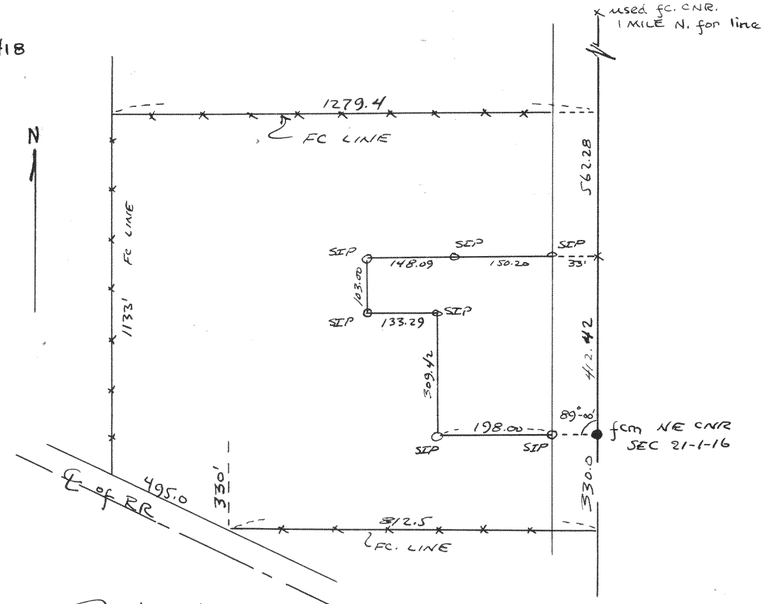


Plat of survey of Brieschke land located in Sections 21 & 16
T1N R16E, Walworth County, Wisconsin

Lloyd S. Jensen QRB
County Surveyor

1951

2419

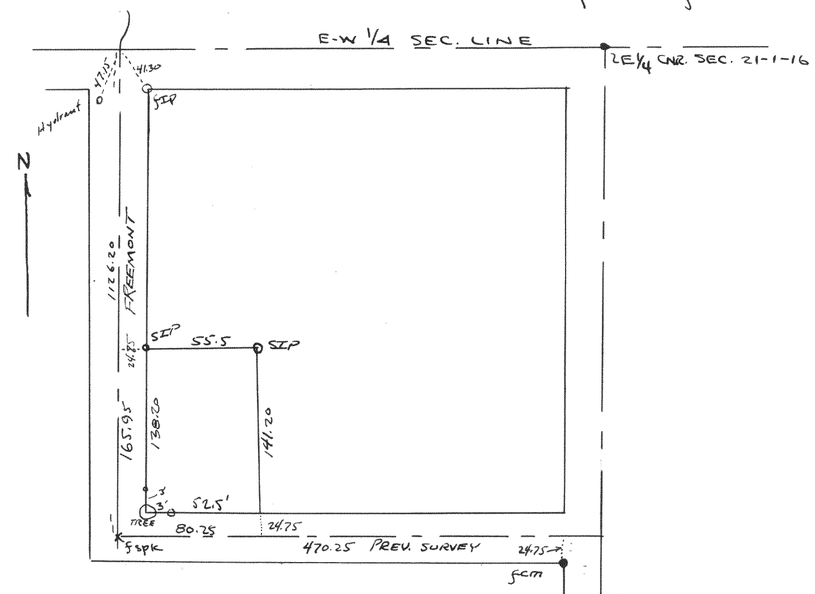

Plat of survey of Lot 19 (except the East 60 ft.) of Phillips Add., Village of Walworth, Walworth County, Wis.
Oct 4, 1951

Lloyd S. Jensen QRB
County Surveyor