

2420

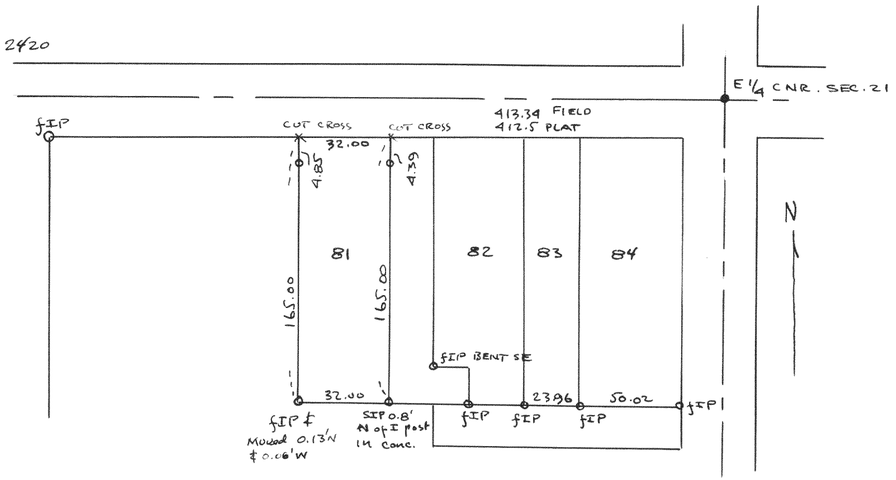

Plat of survey of O.L. 81 Village of Walworth, Walworth County, Wisconsin
Oct. 8, 1951

Lloyd S. Jensen RLS
County Surveyor


2421

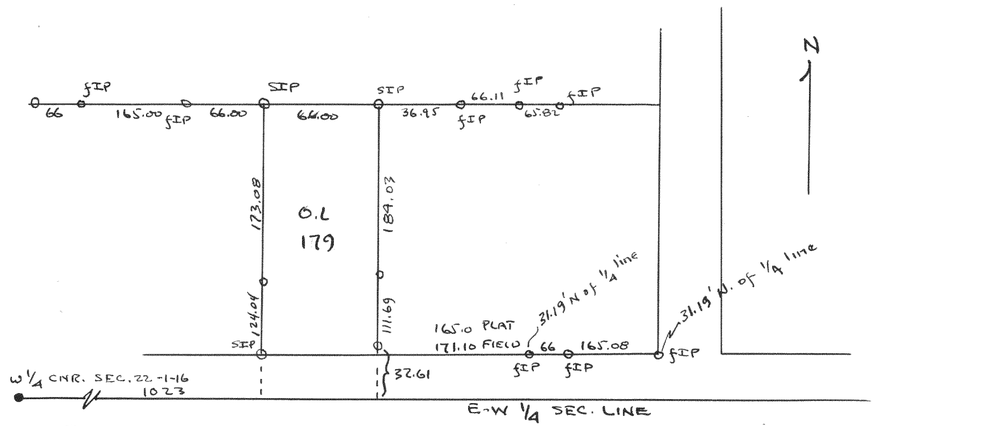

Plat of survey of O.L. 179 Village of Walworth, Walworth County, Wisconsin
Oct. 9, 1951

Lloyd S. Jensen RLS
County Surveyor


2422

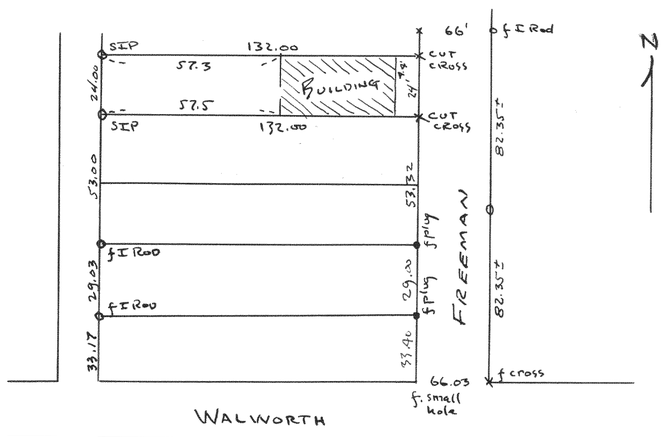

Plat of survey of the Hardware Store located on the S 24' of the north 47 feet of lot 25 Freemans Addition to the Village of Genoa City, Walworth County, Wisconsin
March 2, 1951

Lloyd S. Jensen RLS
County Surveyor

2423

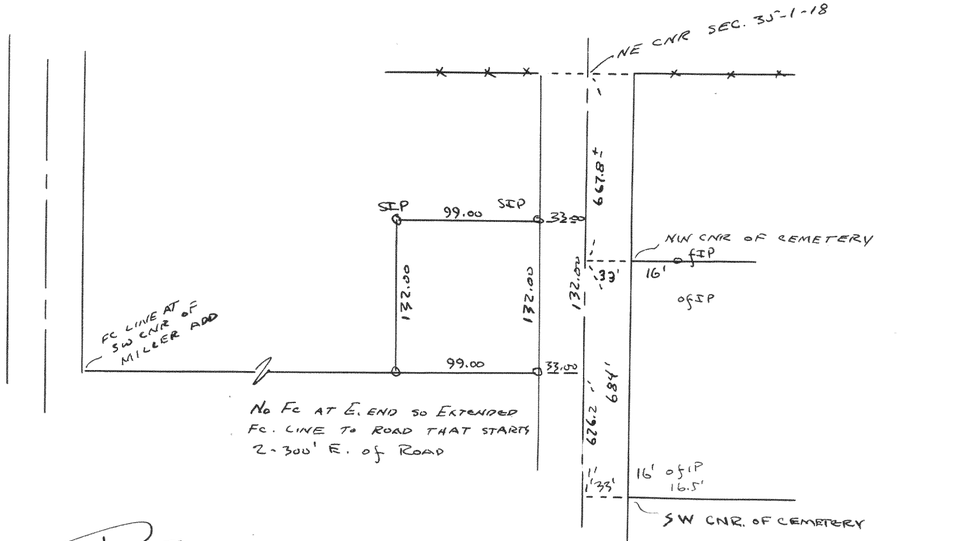

Plat of survey of land located in the NE 1/4 of Section 35 T1N R18E, Village of Genoa City, Walworth County, Wis.
Aug. 10, 1951

Lloyd S. Jensen RLS
County Surveyor