
580


2427

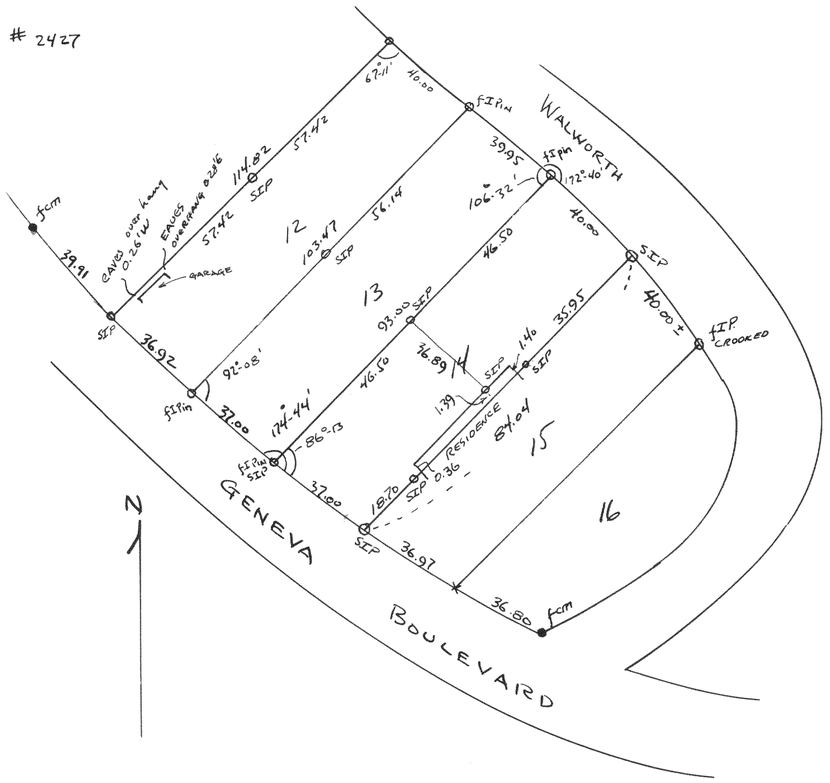

Plat of Survey of lots 12 & 14, Block 7
Glenwood Springs, Village of Fontana,
Walworth County, Wisconsin
Oct 26, 1951

Lloyd L. Jensen qeb
County Surveyor


2428

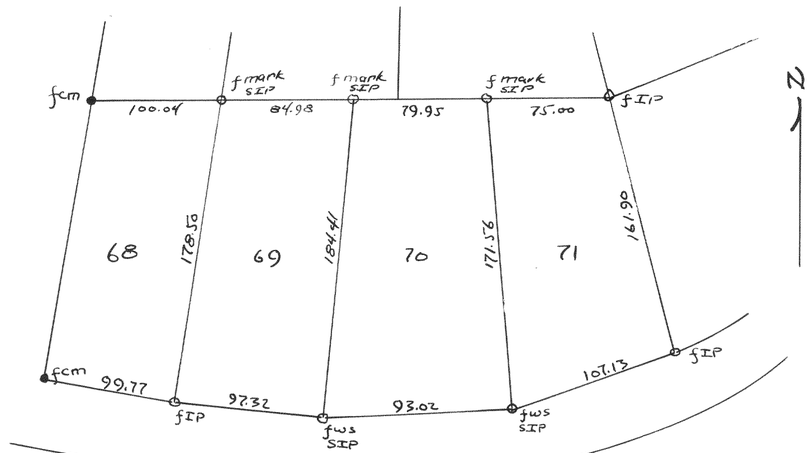

Plat of survey of lots 69, 70 & 71 of Unit 2 Country Club Estates, Village of Fontana, Walworth County, Wisconsin
Nov 6, 1951

Lloyd L. Jensen qeb
County Surveyor

2429

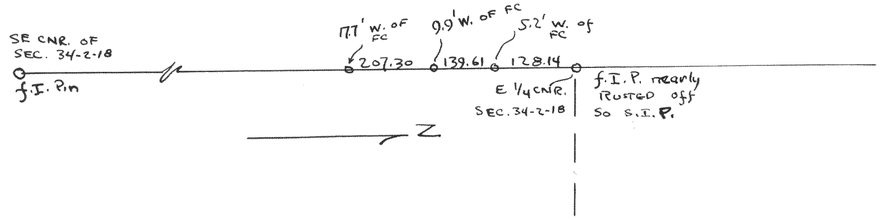

Plat of iron pipe set on the S½ of the East line of Section 34-2-18
Walworth County, Wisconsin
1951

Lloyd L. Jensen qeb
County Surveyor