

2430

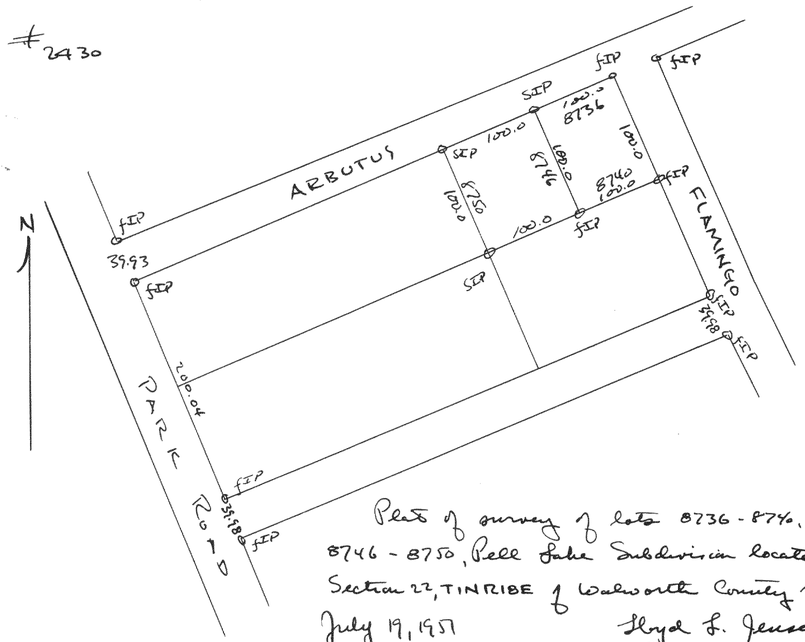


Plats of survey of lots 8736 - 8746, 8746 - 8750, Peel Lake Subdivision located in Section 22, TIN RIBE of Walworth County Wisconsin
July 19, 1951
Floyd L. Jensen RLS
County Surveyor

2431

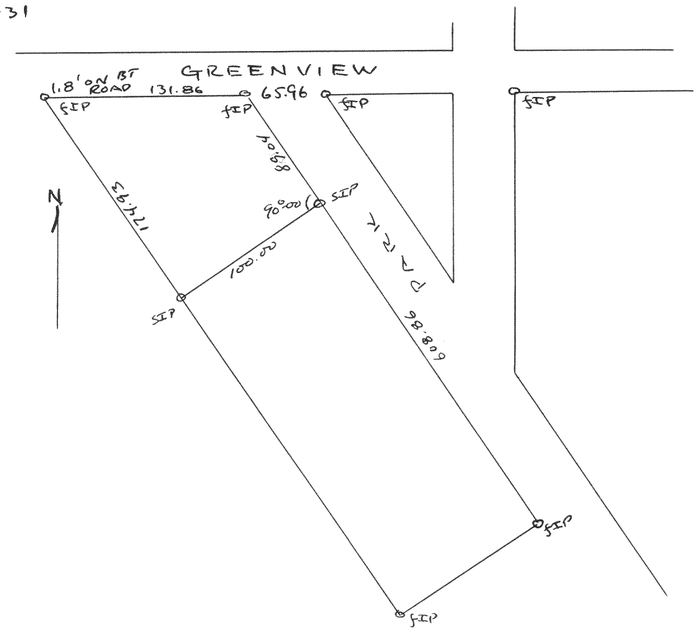


Plats of survey of lots 1048-1052, Peel Lake Subdivision located in Sec 21, TIN RIBE, Walworth County, Wisconsin
Aug. 4, 1951
Floyd L. Jensen RLS
County Surveyor

2432

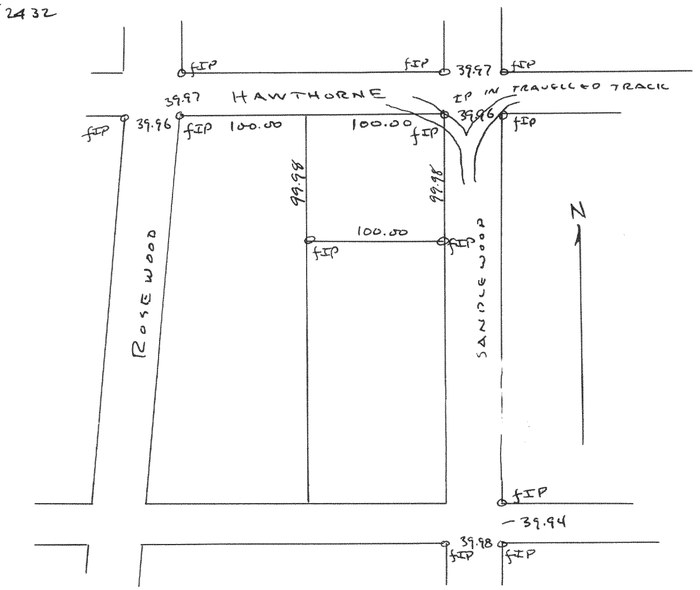

Plats of survey of of lots 2323-2327 Peel Lake Subdivision
Walworth County, Wisconsin
Aug. 4, 1951
Floyd L. Jensen RLS
County Surveyor

2433

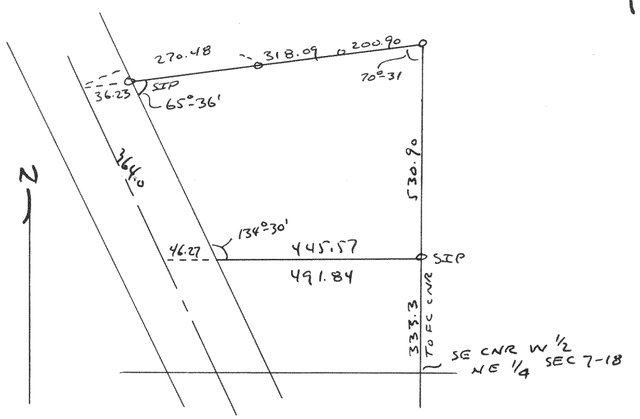

Plats of survey of 6 acre parcel for Richert located in the NE 1/4 of Sec 7-7-18, Walworth County, Wisconsin
1951
Floyd L. Jensen RLS
County Surveyor