

2434

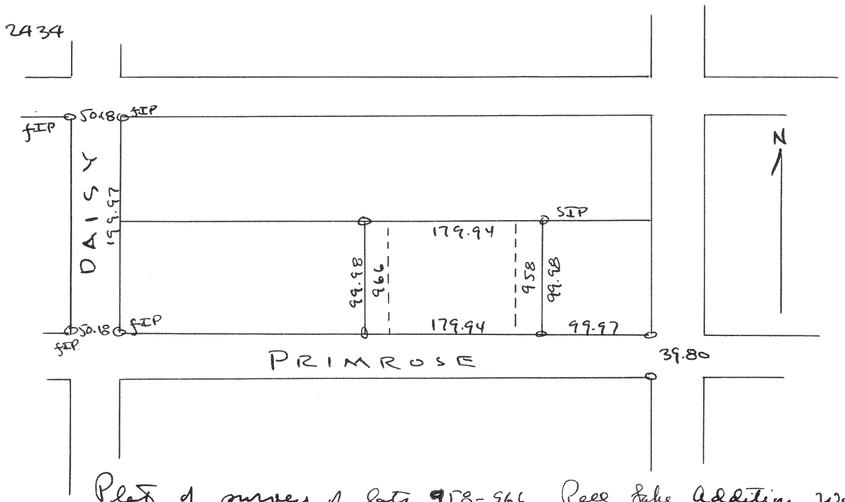

Plat of survey of lots 958-966, Pell Lake Addition, Walworth County, Wisconsin
1951

Floyd L. Jensen RLS
County Surveyor


2435

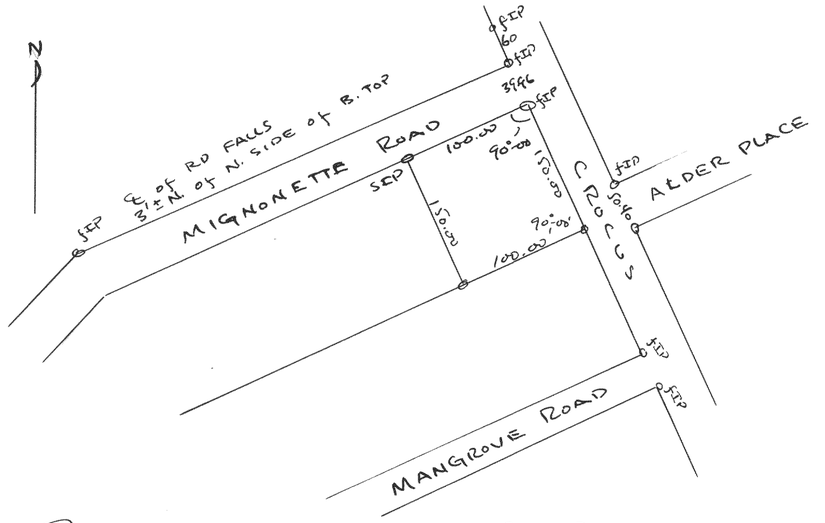

Plat of survey of lots 6724-6728, Pell Lake Subdivision TINRIBE, Walworth County, Wisconsin
Sept 7, 1951

Floyd L. Jensen RLS
County Surveyor

2436

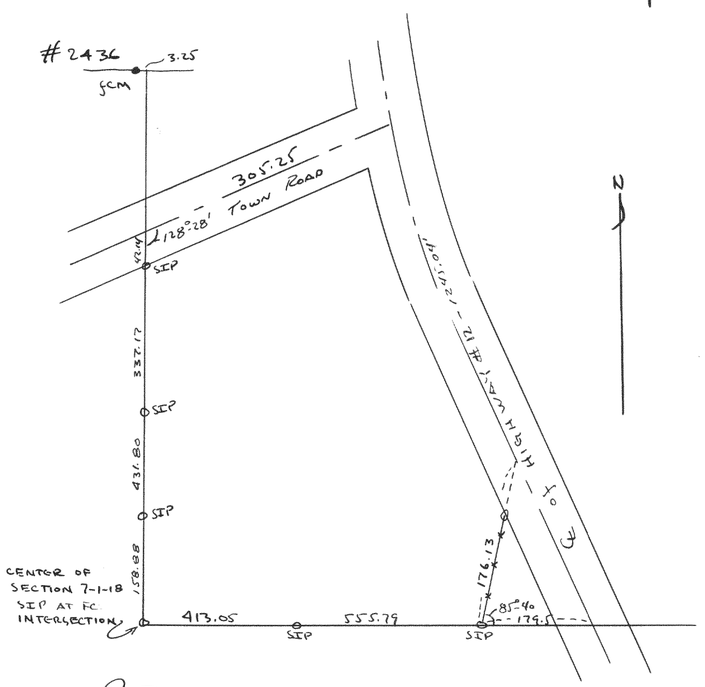

Plat of survey of a parcel of land owned by Riechert located in the NE 1/4 of Sec 7-1-18 Walworth County, Wisconsin
Nov. 18, 1951

Floyd L. Jensen RLS
County Surveyor