
2437

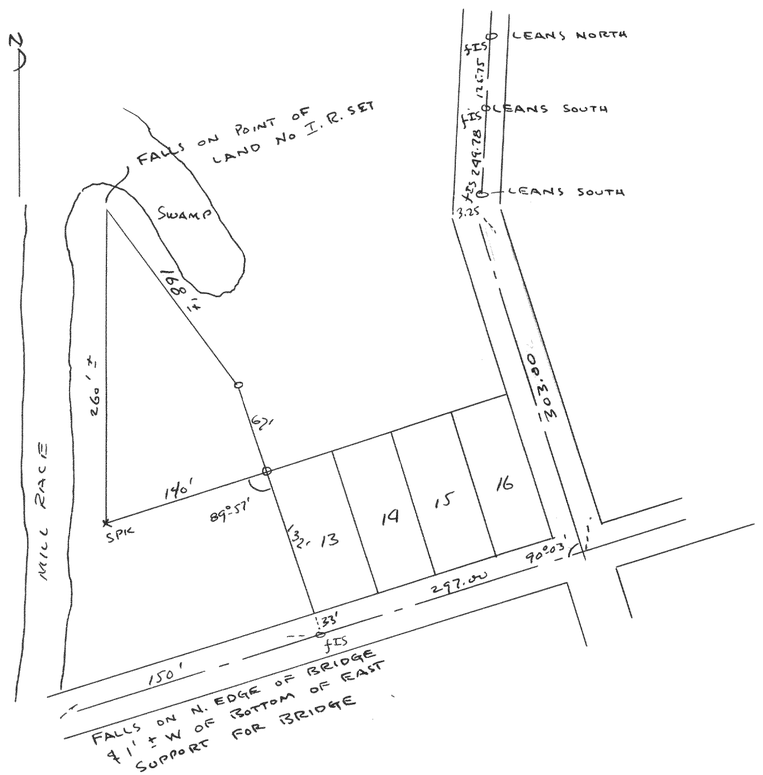


Plats of survey of parcel of land located between Lot 13 of Original Town and the Mill Race, Village of Lyons Walworth County, Wisconsin

April 18, 1951

Floyd L. Jensen RCE
County Surveyor

2438

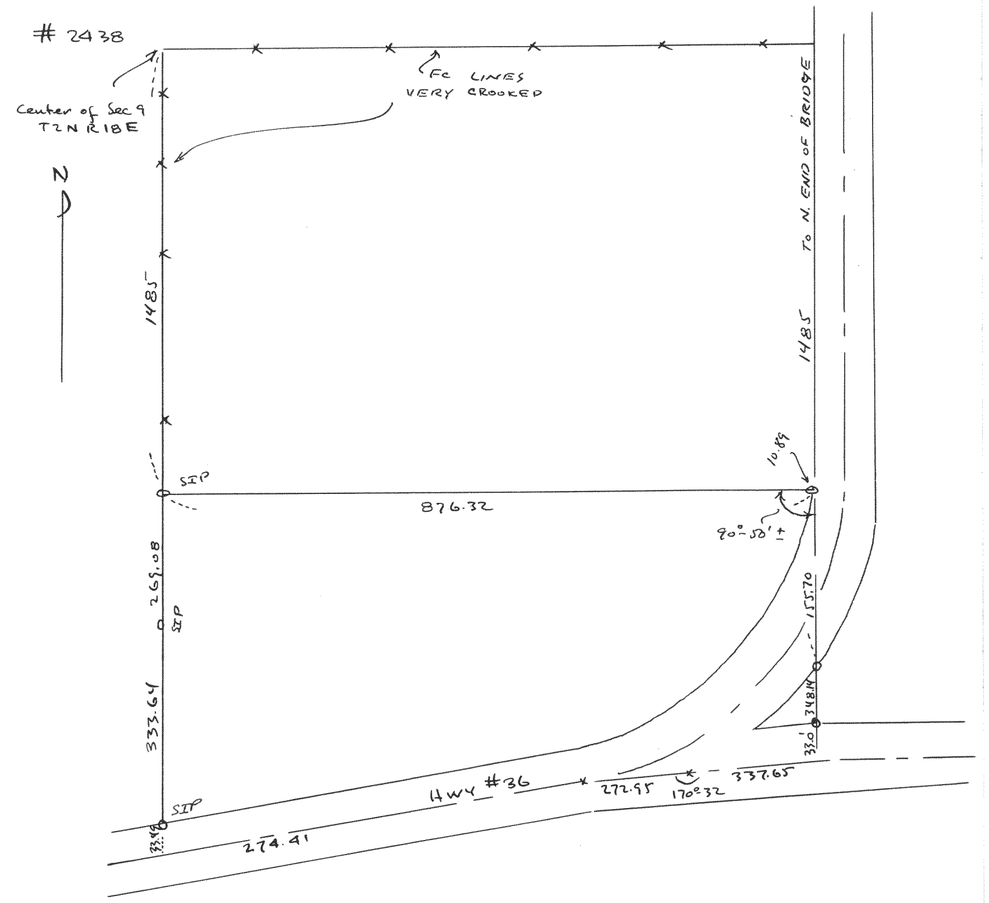

Plats of survey of Fellows property located in the SE 1/4 of Sec 9- 2-18 Walworth County, Wisconsin

Sept 14, 1951

Floyd L. Jensen RCE
County Surveyor