
#2439

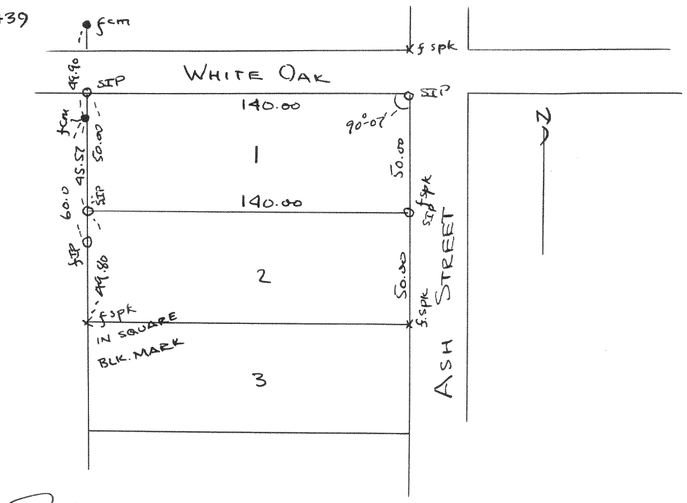


Plat of survey of lot 1, Block 9 Miramar Subd. located in Section 10, T4N R18E of Walworth County, Wisconsin

February 27, 1951

Lloyd L. Jensen RE
County Surveyor

#2440

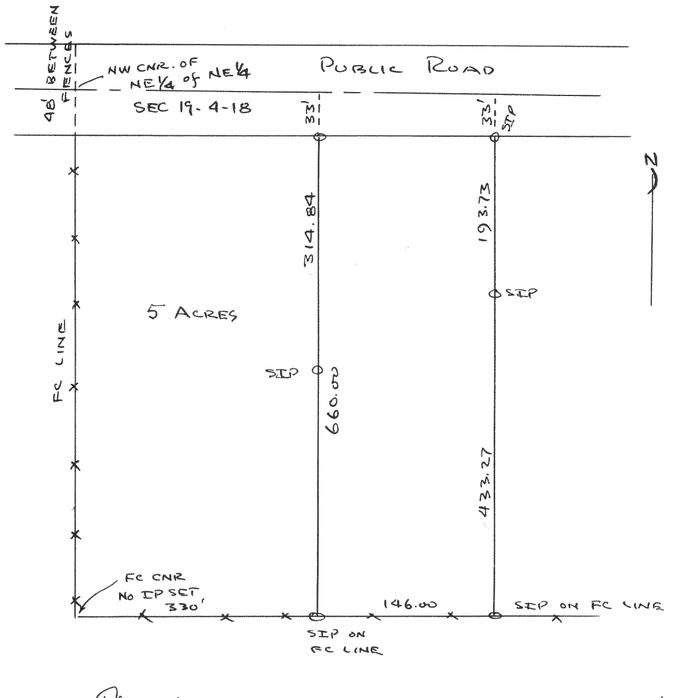


Plat of survey of land located in the NE 1/4 of Sec 19, T4N R18E, Walworth County, Wisconsin

1951

Lloyd L. Jensen RE
County Surveyor

#2441

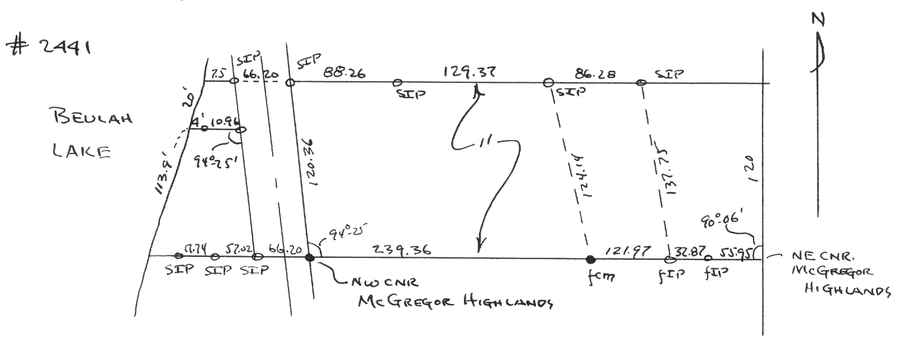

Plat of survey of the Johnson Property located North of Mc Gregor Highlands Subdivision in the NE 1/4 of Section 9, T4N R18E, Walworth County, Wisconsin

July 22, 1951

Lloyd L. Jensen RE
County Surveyor