

2442

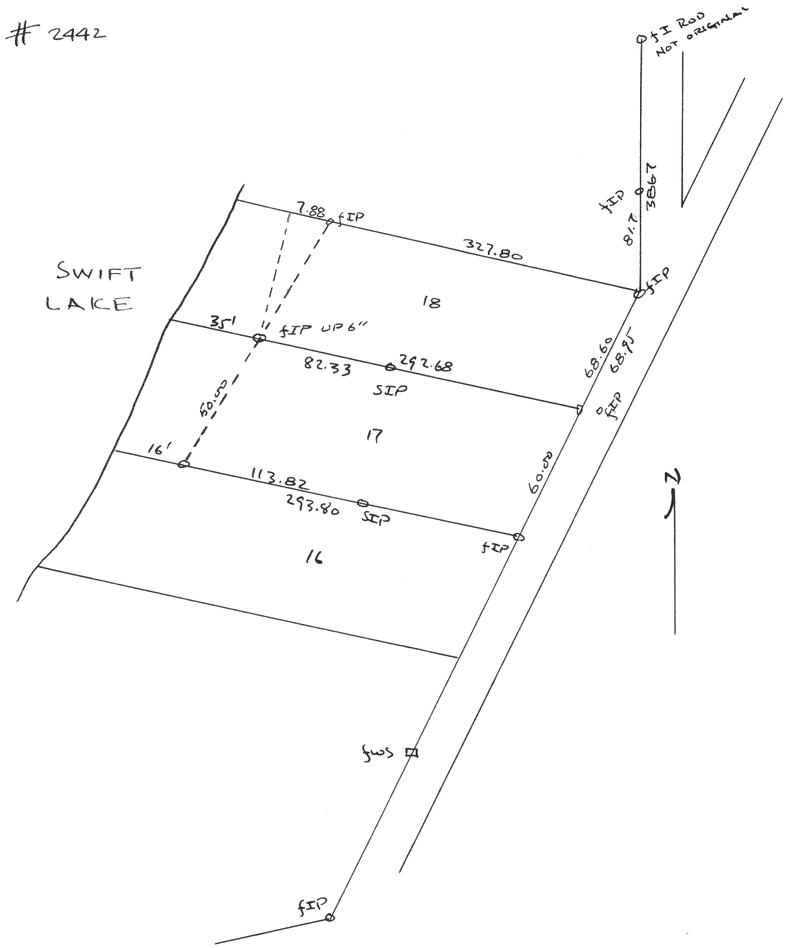

Plat of survey of Lot 17, Blk 2 of Swift Lake Subdivision located in Sec. 8, T4NR17E, Walworth County, Wisconsin
Aug. 27, 1951

Floyd S. Jensen PLS
County Surveyor

2443

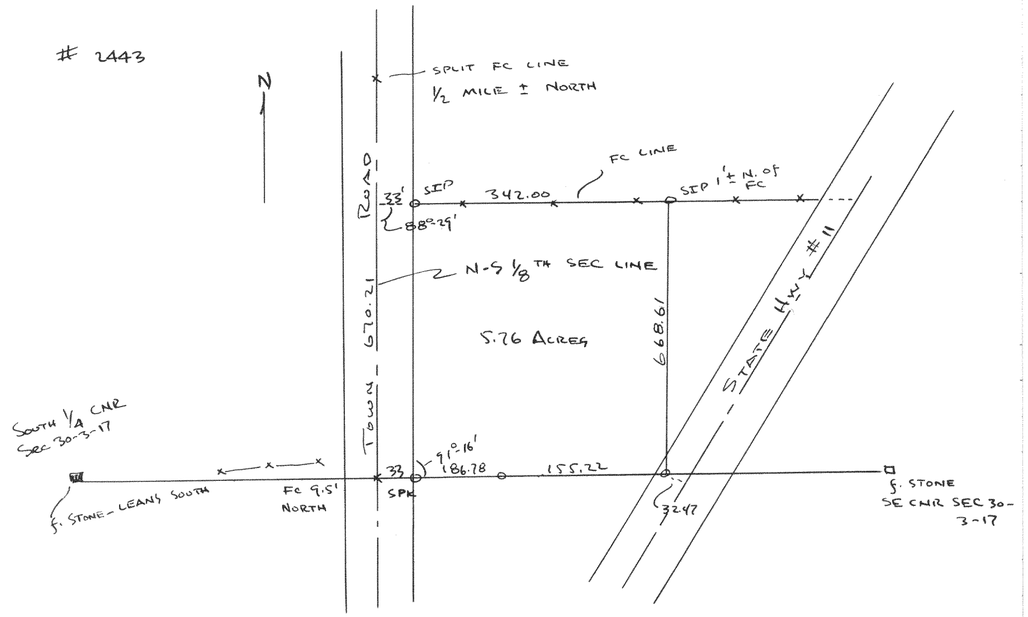

Plat of survey of a parcel of land on the Anderson Farm located in the SE 1/4 of Section 30 - T3NR17E, Walworth County, Wisconsin
Aug. 28, 1951

Floyd S. Jensen PLS
County Surveyor