

2444

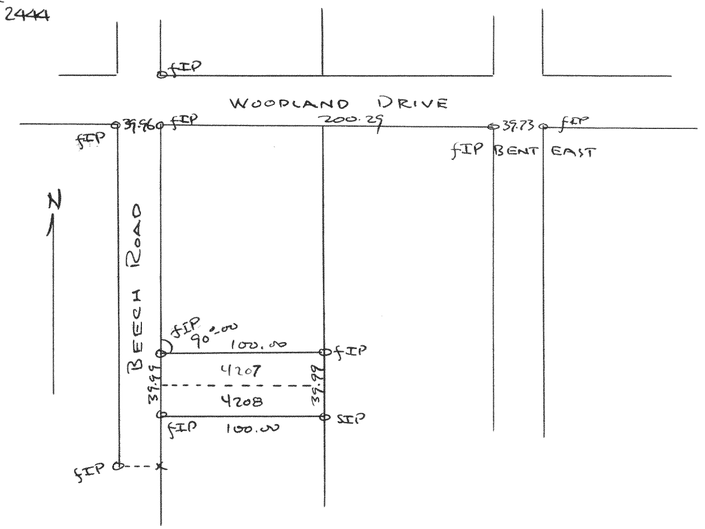

Plat of survey of lots 4207-4208, Lake Como Beach Subdivision
T2N R17E, Walworth County, Wisconsin
June 9, 1951

Floyd L. Jensen PLS
County Surveyor


2445

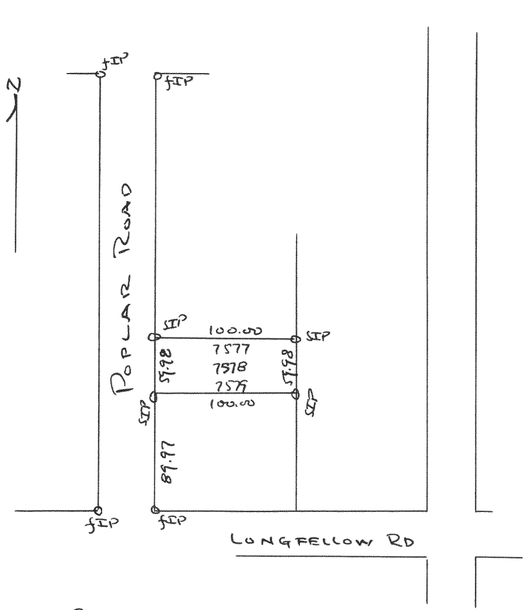

Plat of survey of lots 7577-7579 Lake Como Beach Subdivision
in T2N R17E, Walworth County, Wisconsin
July 10, 1951

Floyd L. Jensen PLS
County Surveyor


2446

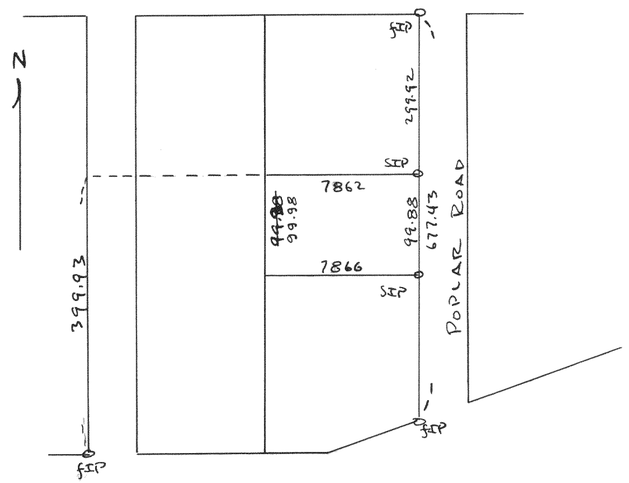

Plat of survey of lots 7862-7866, Lake Como Beach Subdivision
located in T2N R17E, Walworth County, Wisconsin
July 14, 1951

Floyd L. Jensen PLS
County Surveyor

2447

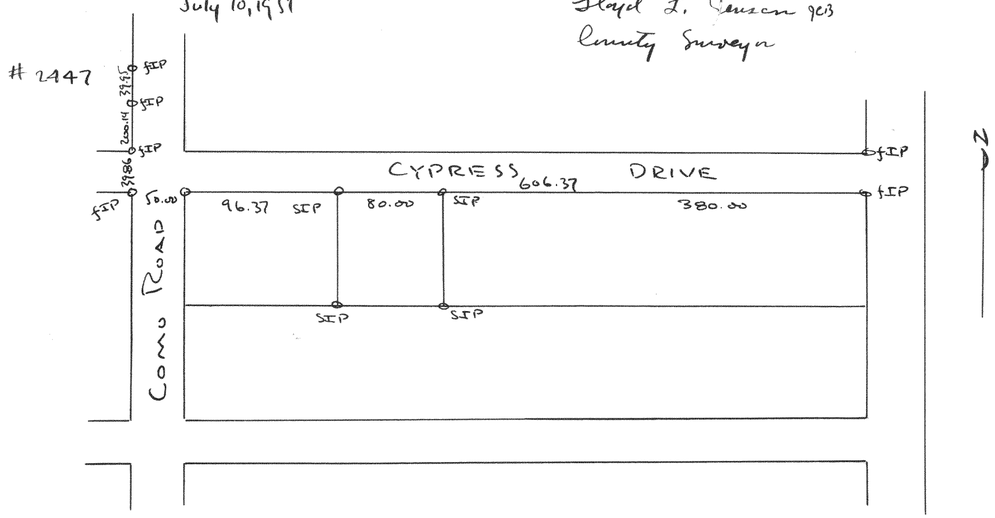

Plat of survey of lots 8947-8950 of Lake Como Beach Subdivision located
in T2N R17E, Walworth County, Wisconsin

Floyd L. Jensen PLS
County Surveyor