

#588

2451

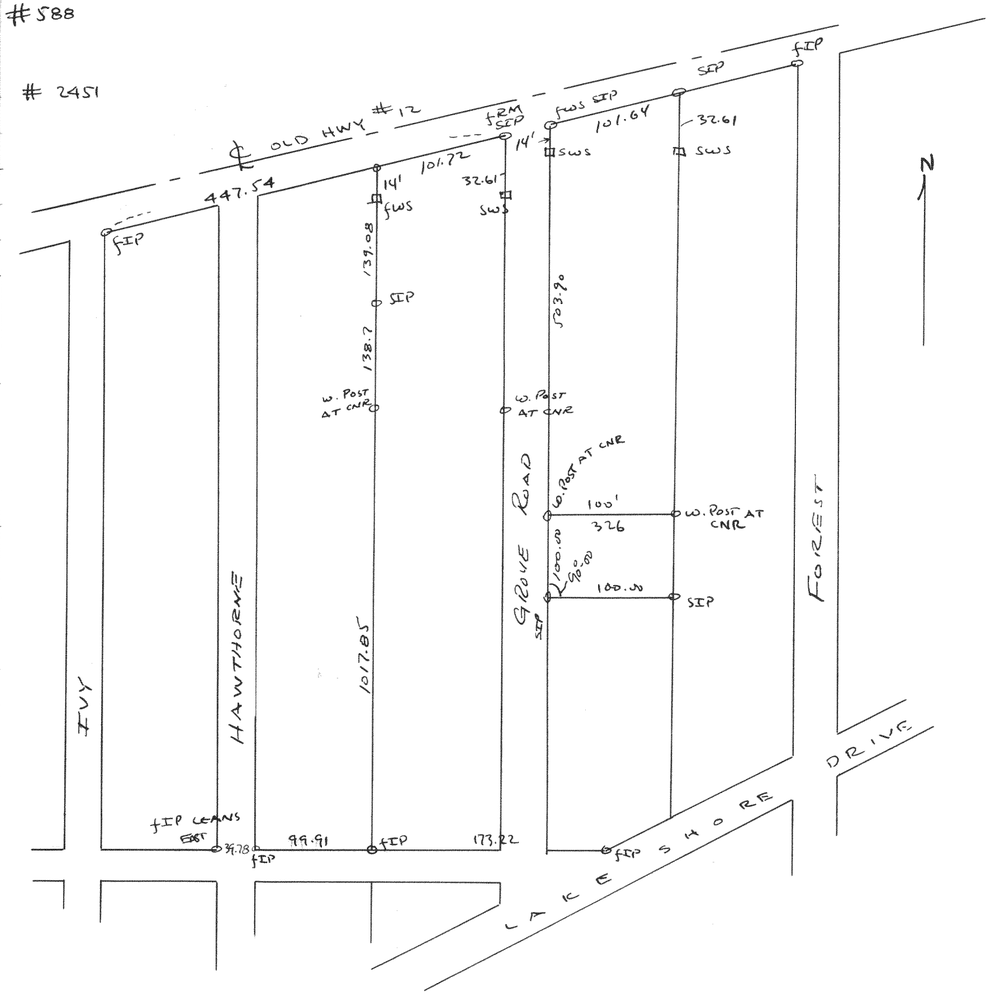

Plat of survey of lots 326-330 and ℄ of Block B, Lake Como Beach Subdivision in T2N R17E, Walworth County, Wisconsin
Sept 29, 1951
Floyd L. Jensen RLS
County Surveyor

2452

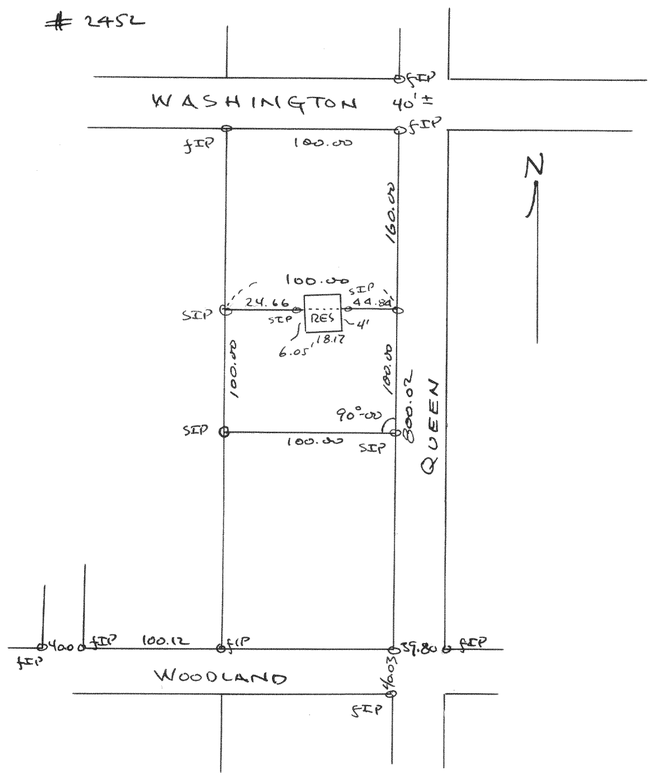

Plat of survey of lots 2227-2231 Lake Como Beach Subdivision in T2N R17E, Walworth County, Wisconsin
Oct 2, 1951
Floyd L. Jensen RLS
County Surveyor