

2453

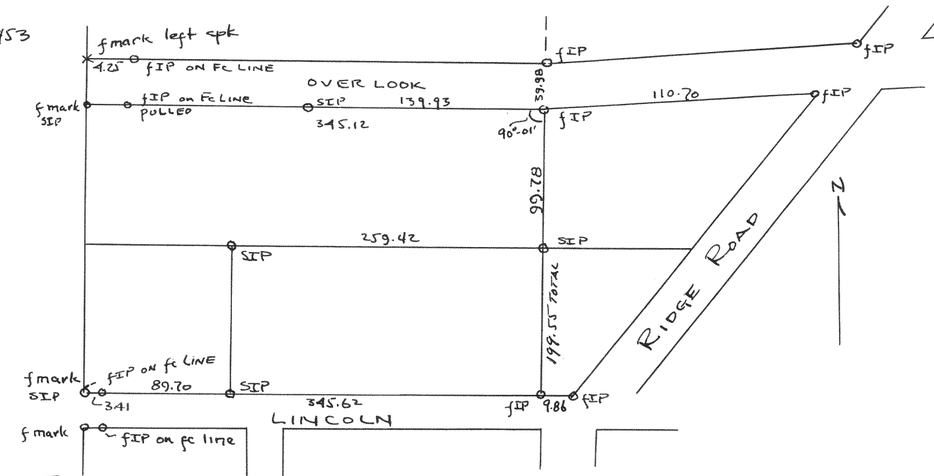

Plat of survey of lots 12538-12560 Lake Como Beach Subdivision T2NR17E, Walworth County, Wisconsin
Oct 27, 1951

Floyd L. Jensen qeb
County Surveyor


2454

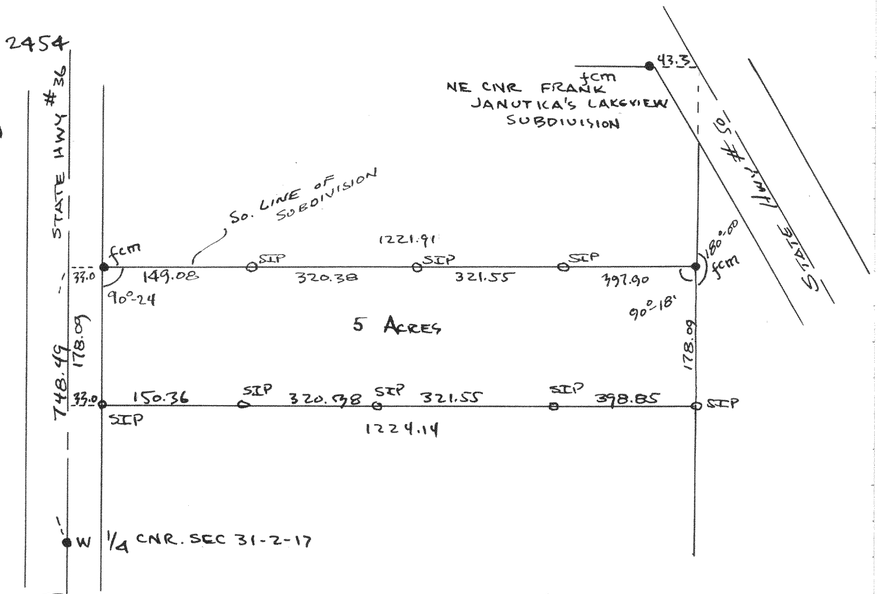

Plat of survey of 5 Acre parcel for Kolacek located in the NW1/4 of Section 31, T2NR17E, Walworth County, Wisconsin
Nov 2, 1951

Floyd L. Jensen qeb
County Surveyor


2455

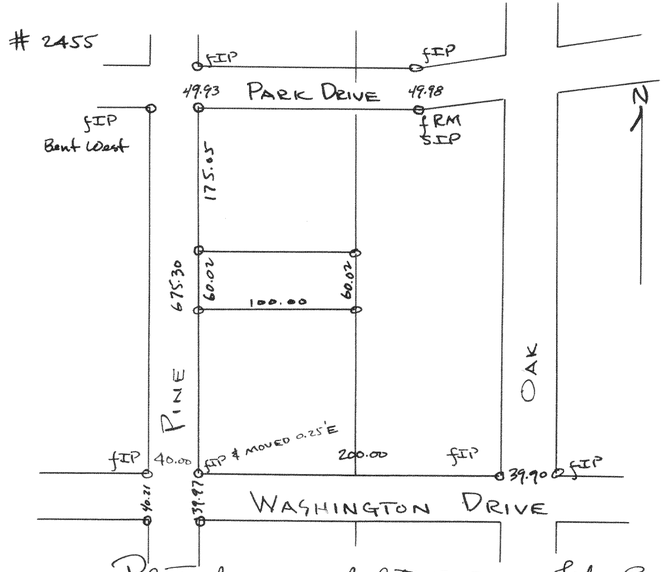

Plat of survey of lots 1725-1727 Lake Como Beach Subdivision T2NR17E, Walworth County, Wisconsin
Nov. 8, 1951

Floyd L. Jensen qeb
County Surveyor

2456

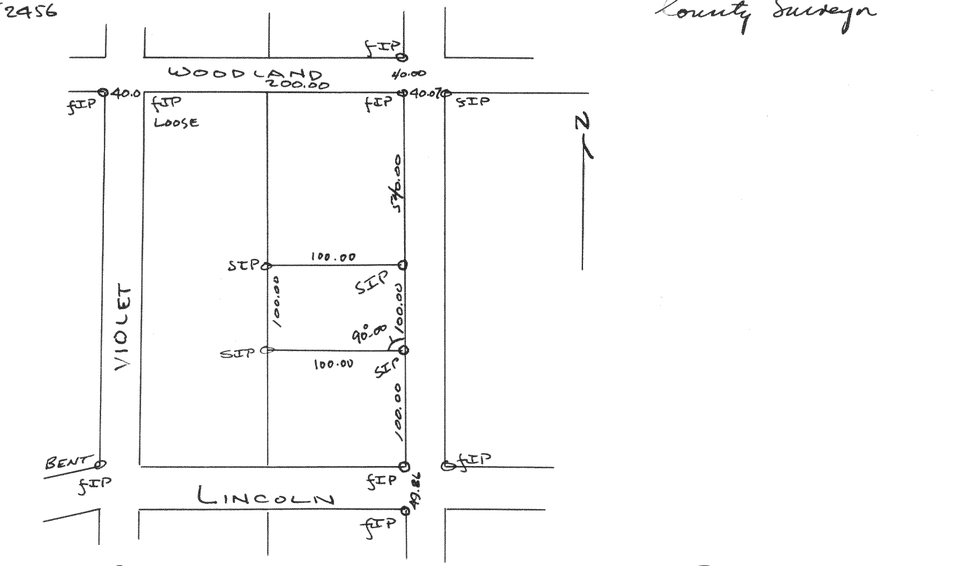

Plats of survey of lots 10862-10866 Lake Como Beach Subdivision
T2NR17E, Walworth County, Wisconsin
Nov. 8, 1951

Floyd L. Jensen qeb
County Surveyor