

## SURVEY NO. 1291

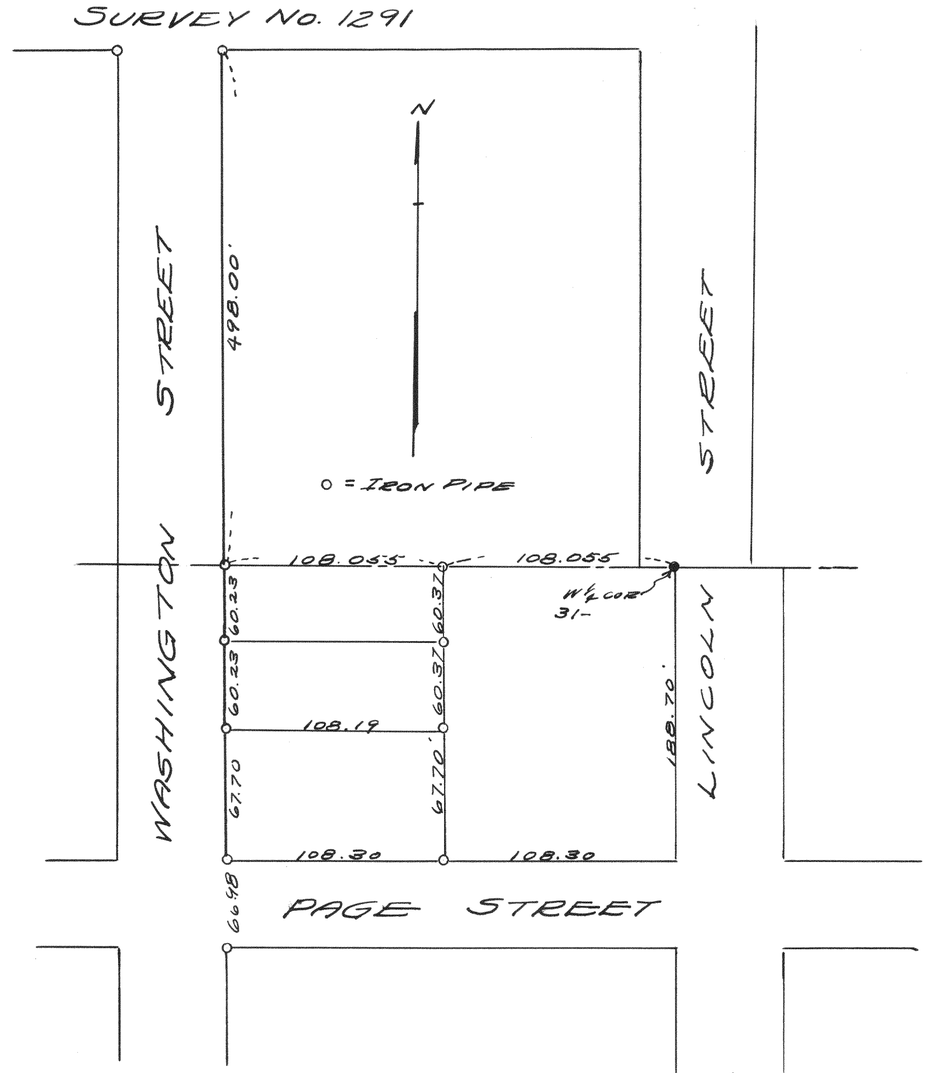


PLAT OF SURVEY OF LOT 3 & W½ OF LOT 2 OF BLOCK 2, OF THE ORIGINAL PLAT OF THE CITY OF ELKHORN, WALWORTH CO., WISC.
DEC. 1942

Lloyd L. Jensen
R.E.S.

## SURVEY NO. 1292

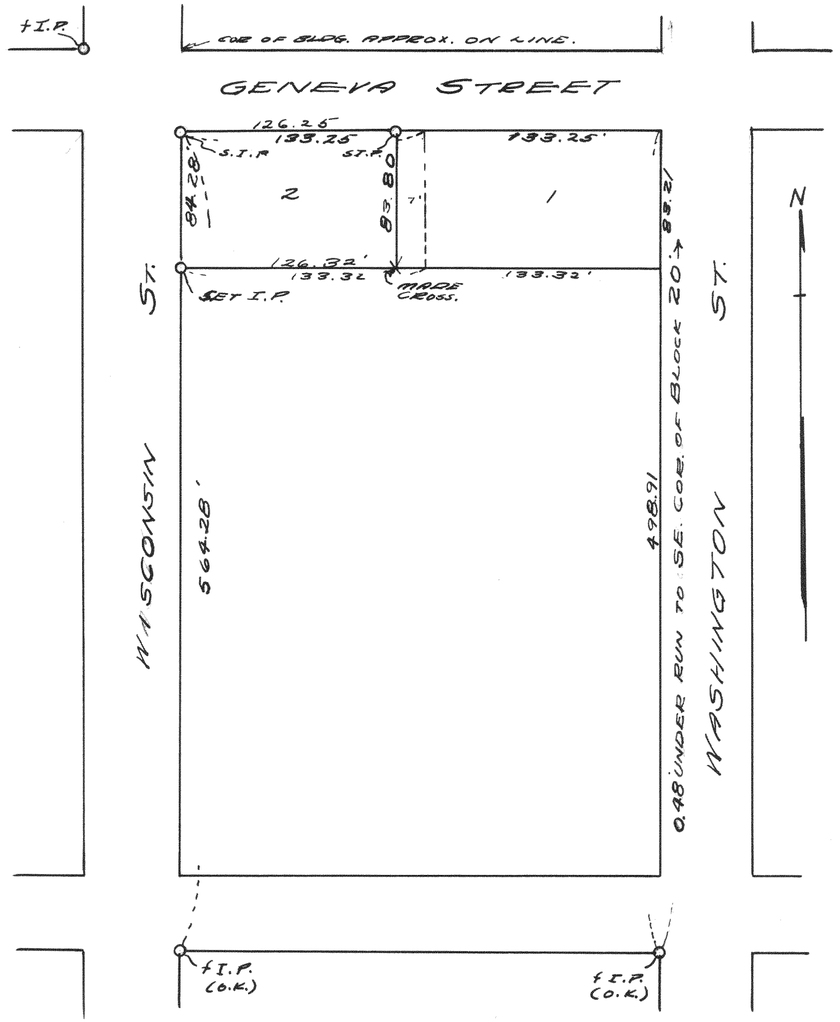


PLAT OF SURVEY OF LOT 2 (EXCEPT THE EAST 7' THEREOF) OF BLK. 32 OF THE ORIGINAL TOWN OF ELKHORN, WALWORTH COUNTY, WISCONSIN
MAY, 1941

Lloyd L. Jensen
R.E.S.