

#2461

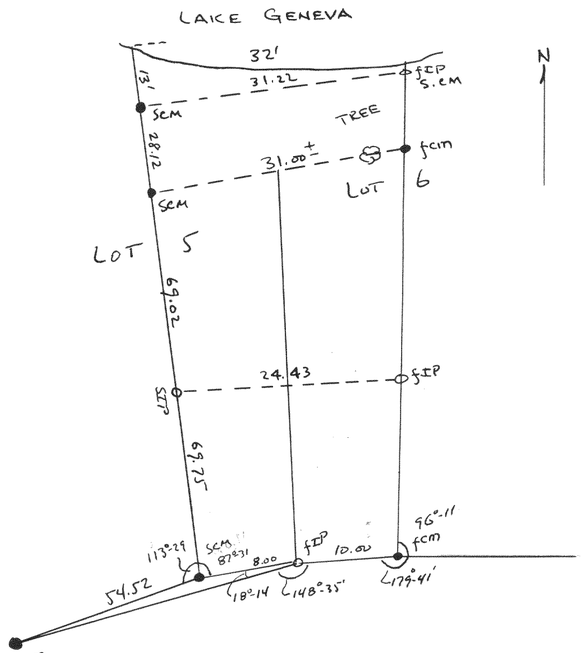

Plat of survey of part of lots 5 & 6
Block I, Woodale Subd. TINRITE, Walworth County, Wisconsin
April 23, 1951

Floyd L. Jensen RCE
County Surveyor

#2462

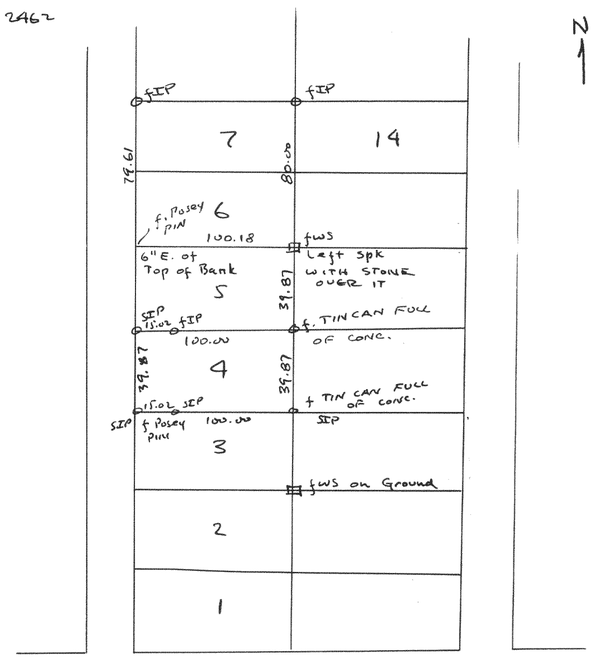

Plat of survey of lot 4, Blk D, Cisco Beach Subdivision
located in T1N R17E, Walworth County, Wisconsin
June 6, 1951

Floyd L Jensen RCE
County Surveyor