

#2463

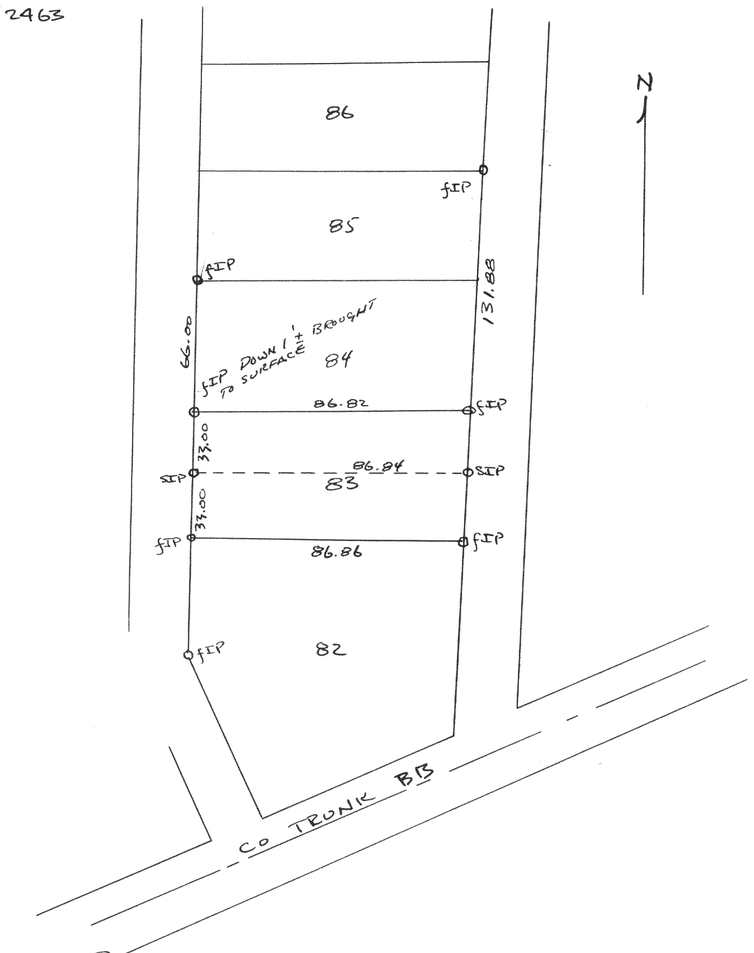

Plat of survey of the N½ of lot 83, Robinsons 2nd Subd. located in the NW¼, Sec 14, T1N R17E, Walworth County, Wisconsin

Lloyd L. Jensen PLS
County Surveyor

#2464

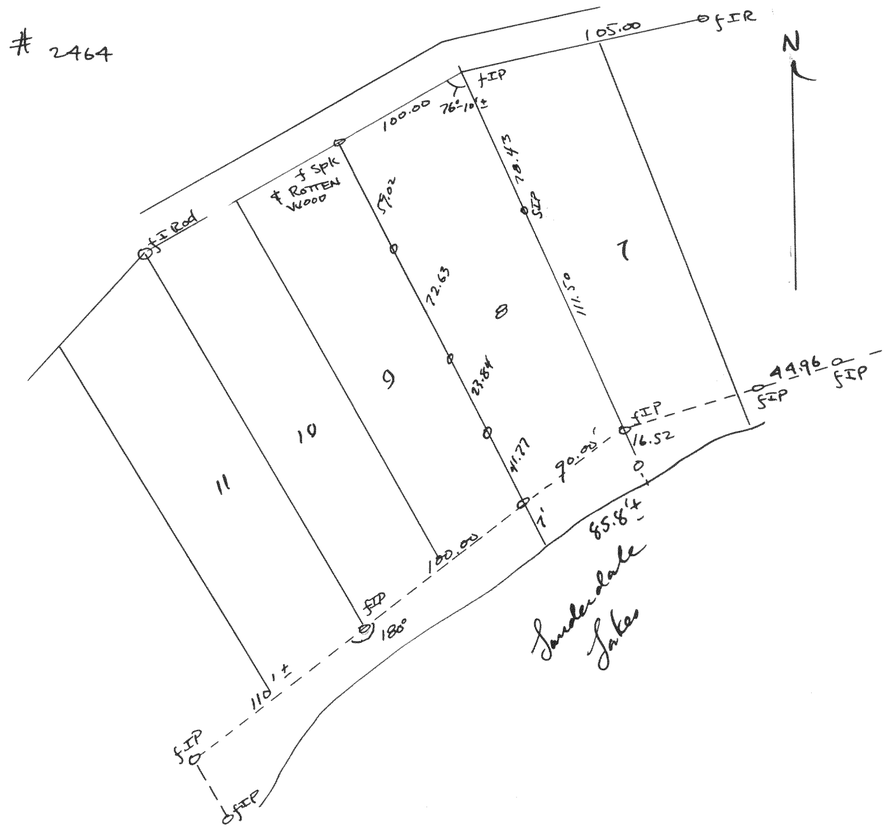

Plat of survey of lot 8, Oak Park Subdivision located in Sec. 26 T4N R16E, Walworth County, Wisconsin

May 17, 1951

Lloyd L. Jensen PLS
County Surveyor