

#2467

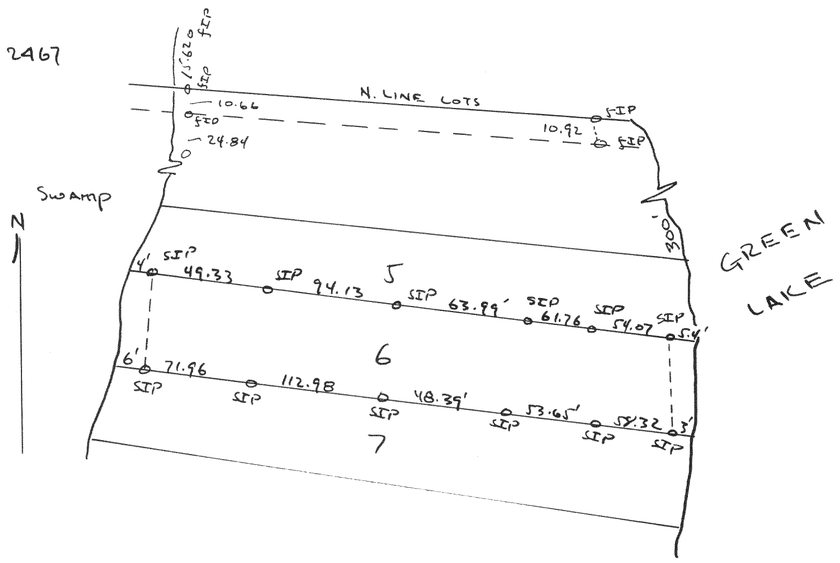

Plat of survey of lot 6 & Inglesade Point Subdivision located in the SE 1/4 of Section 26, T4N R16E of Walworth County, Wisconsin
Aug. 24, 1951

Floyd L. Jensen 913
County Surveyor

#2468

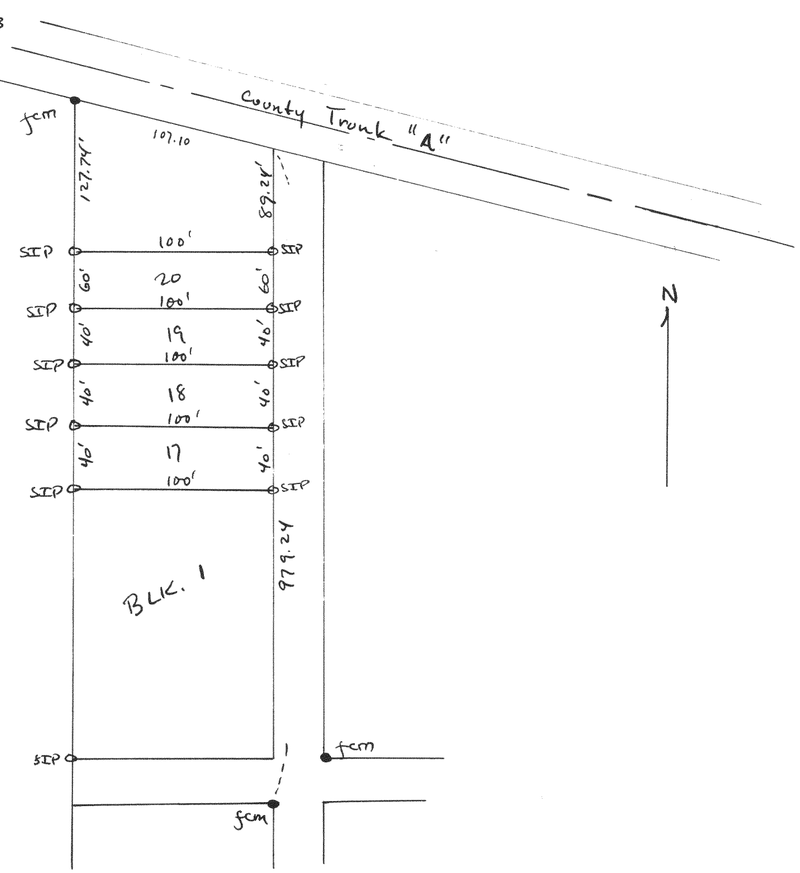

Plat of survey of lots 17-20, Block 1, Inter Lakes Subdivision located in Section 11, T3N R16E, Walworth County, Wisconsin
July 23, 1951

Floyd L. Jensen 913
County Surveyor