

2473

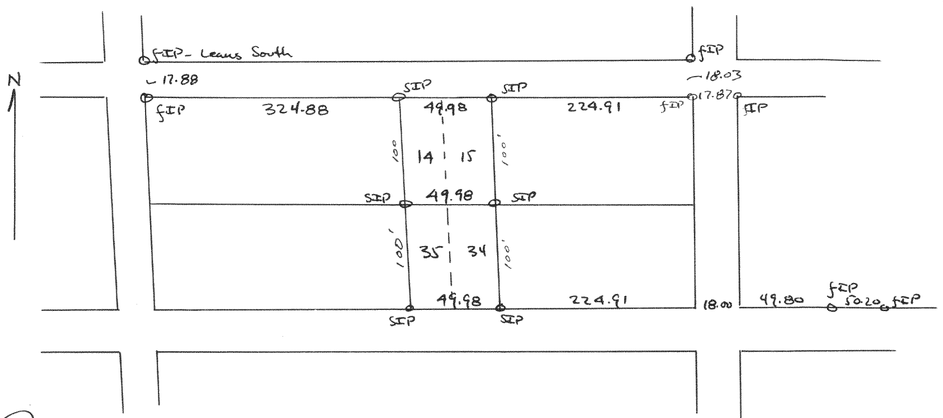

Plat of survey of lots 14-15, 34-35 of Block 102, Lake Wandawega Subdivision located in Section 1, T3N R16E of Walworth County, Wisconsin
Sept 19, 1951

Lloyd L. Jensen 9613
County Surveyor


2474

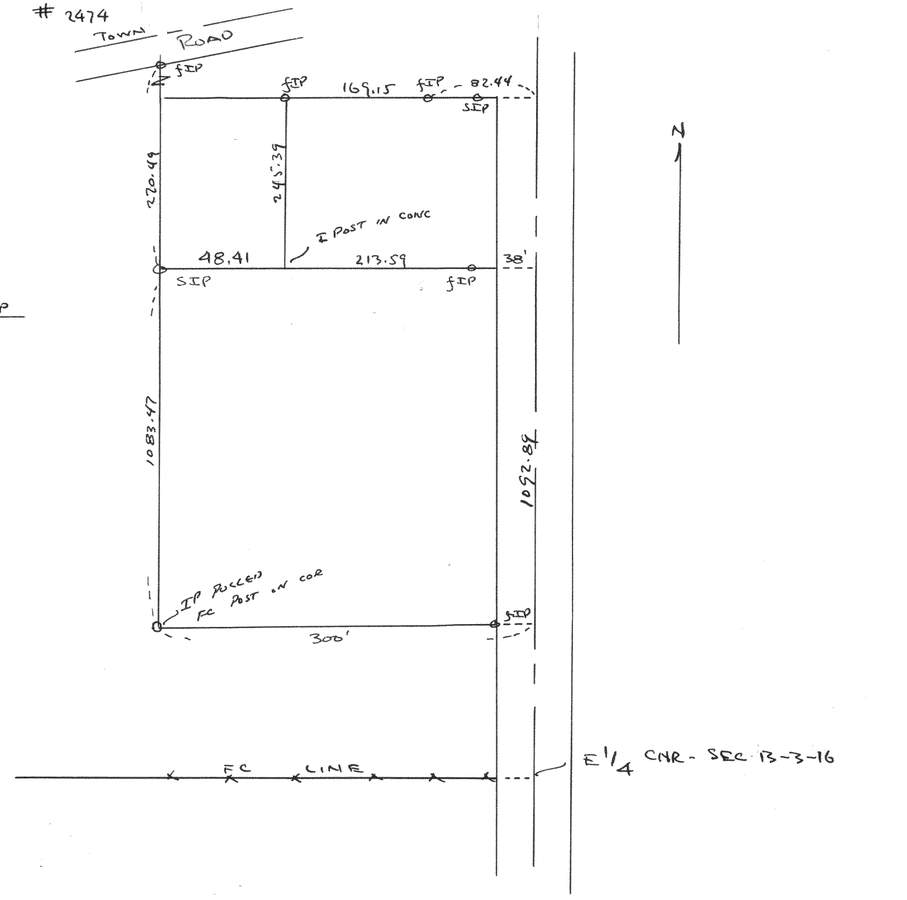

Plat of survey of land south of Sticks located in Section 13, T3N R16E of Walworth County, Wisconsin
Oct 8, 1951

Lloyd L. Jensen 9613
County Surveyor

2475

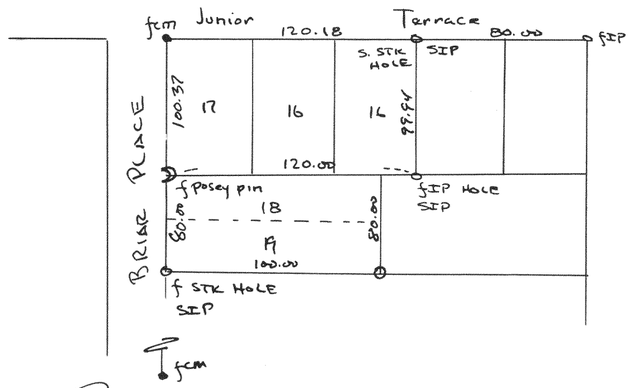

Plat of survey of lots 15-19 Block 11 of South Shore Manor, 1st add located in the SE 1/4 of Section 32 T2N R16E, Walworth County, Wisconsin
March 20, 1951

Lloyd L. Jensen 9613
County Surveyor