

2476

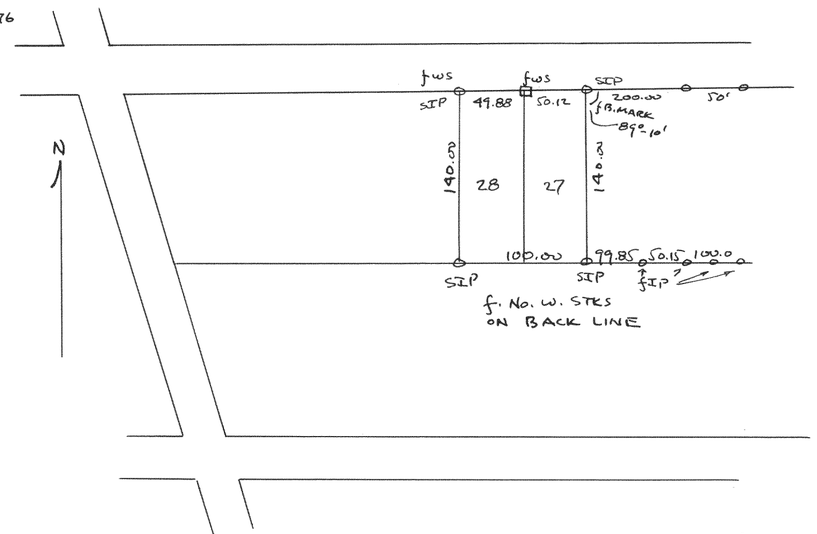

Survey of lots 27 & 28, Block 2, Inlet Oaks Subdivision No 3
located in Section 22, T2NR16E, Walworth County, Wisconsin
March 27, 1951

Floyd L. Jensen geb
County Surveyor


2477

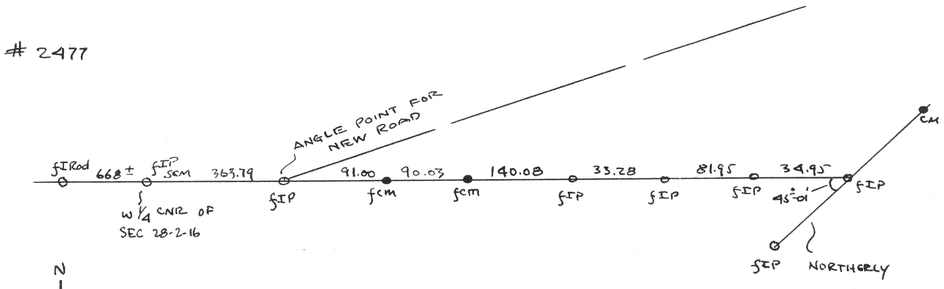

Survey of part of the E-W 1/4 Section line of Section 28
T2NR16E of Walworth County, Wisconsin
April 11, 1951

Floyd L. Jensen geb
County Surveyor


2478

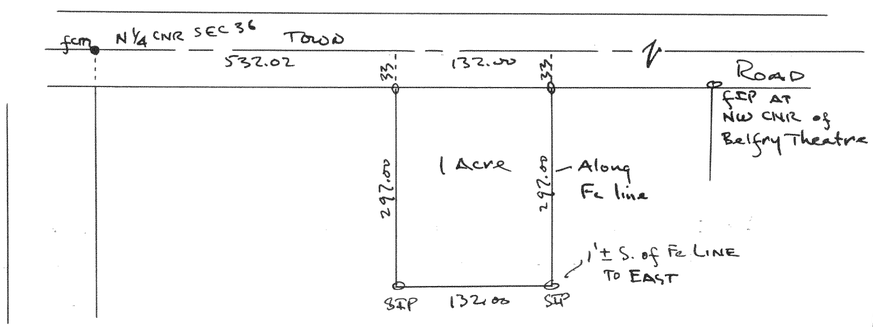

Plat of survey of 1 acre parcel on John Ingersoll property
located in the NE 1/4 of Section 36, T2N R16E, Walworth County, Wisconsin
May 31, 1951

Floyd L. Jensen geb
County Surveyor

2479

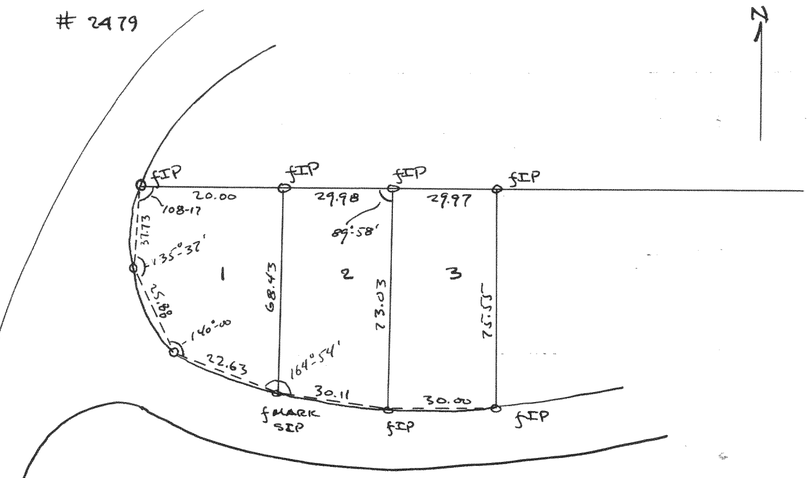

Plat of survey of lots 1 & 2 Block Y of assembly Park located in Section 21, T2N R16E, Walworth County, Wisconsin
Aug. 1, 1951

Floyd L. Jensen geb
County Surveyor