
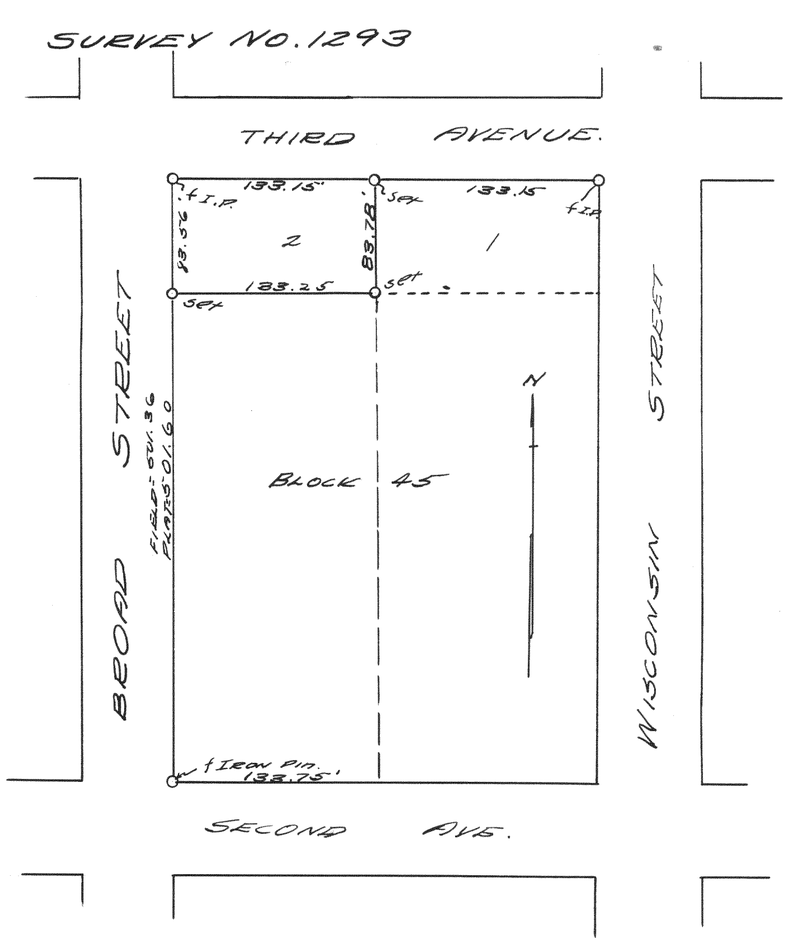


PLAT OF SURVEY OF LOT 2, BLOCK 45 OF DAVIS' ADDITION.
NOV. 1941

Lloyd L. Jensen
R.E.J.

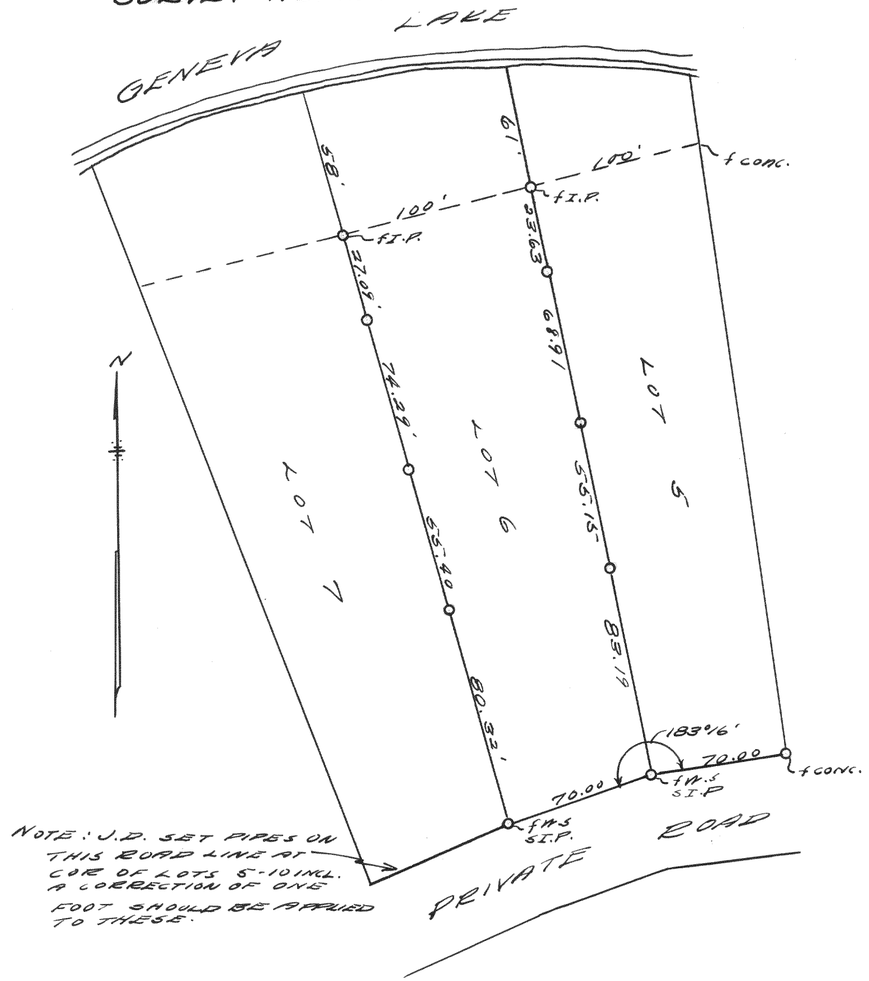

PLAT OF SURVEY OF LOT 6 OF "THE BIRCHES" TINERITE, WALWORTH COUNTY, WISC.
JUNE 7, 1941

Lloyd L. Jensen
R.E.J.