

2480

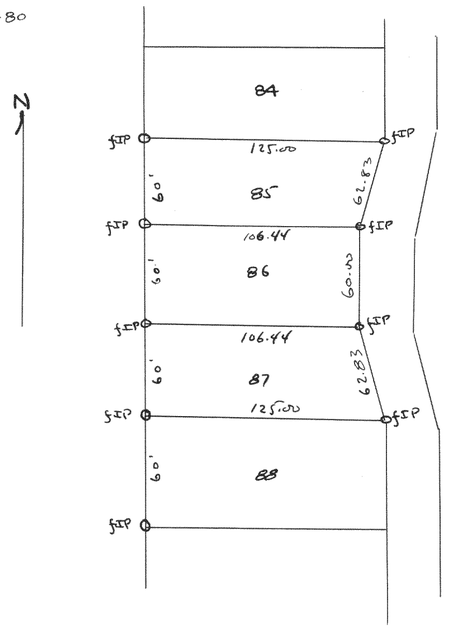

Plat of survey of lots 85, 86, 87 of Lockwood Subdivision located in Section 36, T2N R16E, Walworth County, Wisconsin
Sept 25, 1951
Floyd L. Jensen RLS
County Surveyor

2481

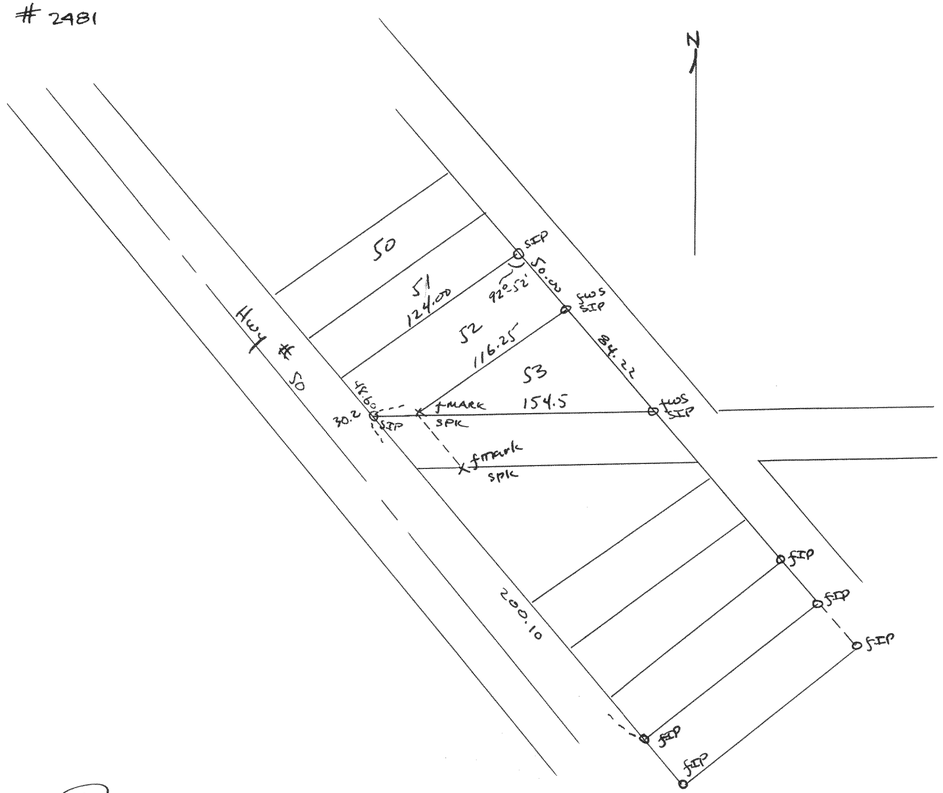

Plat of survey of lots 52 & 53, Block 3 of Inlet Oaks Subdivision located in Section 22, T2N R16E, Walworth County, Wisconsin
Sept., 1951
Floyd L. Jensen RLS
County Surveyor