

2484

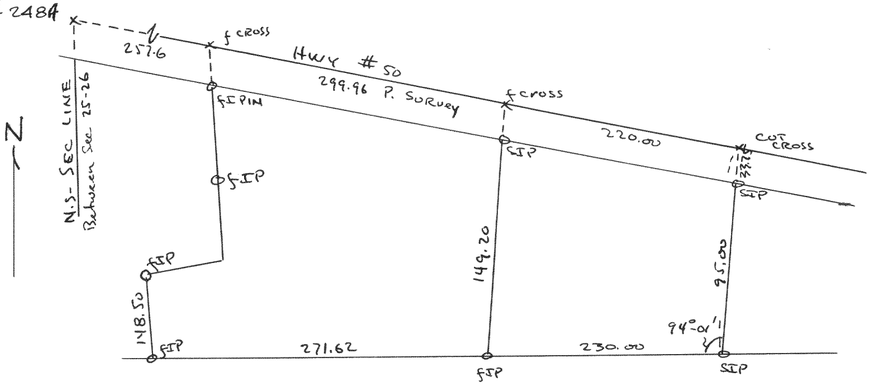

Plat of survey of the Allen Property at East Delavan located in Sec. 25 T 2N R16E, Walworth County, Wisconsin
Nov. 26, 1951

Floyd L. Jensen RLS
County Surveyor


2485

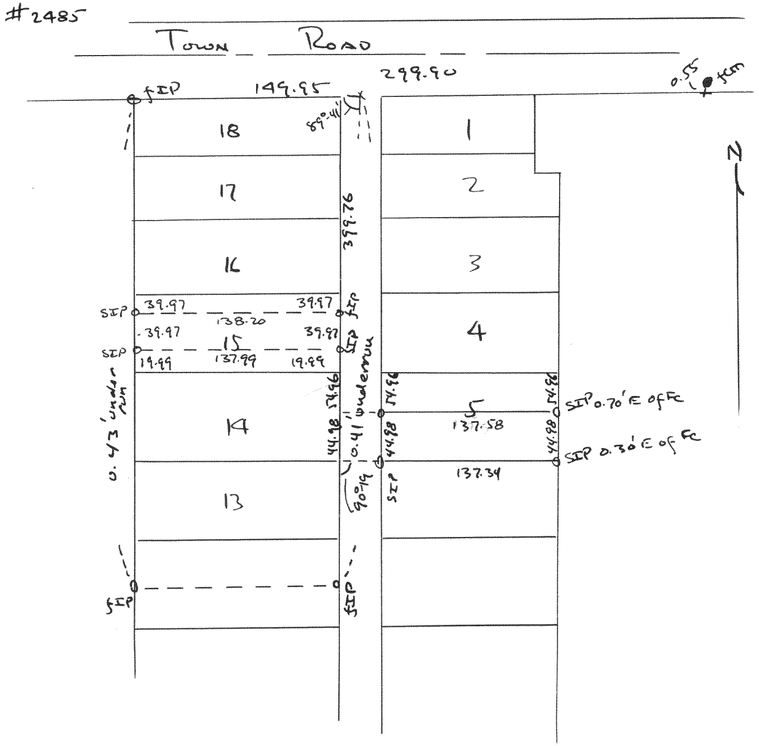

Plat of Survey of parts of lots 5 & 15 of Chicago Club Subdivision located in Section 31 - T2NR16E - Walworth County, Wisconsin
Dec 3, 1951

Floyd L. Jensen RLS
County Surveyor

2486

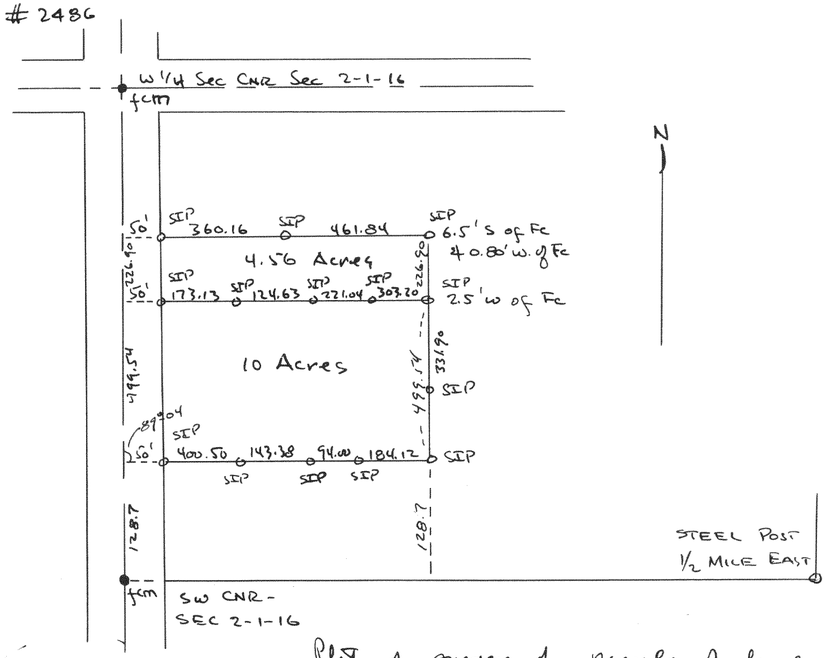

Plat of survey of parcels of land located in SW 1/4, Sec 2-1-16 Walworth County, Wisconsin
1951

Floyd L. Jensen RLS
County Surveyor