

#2491

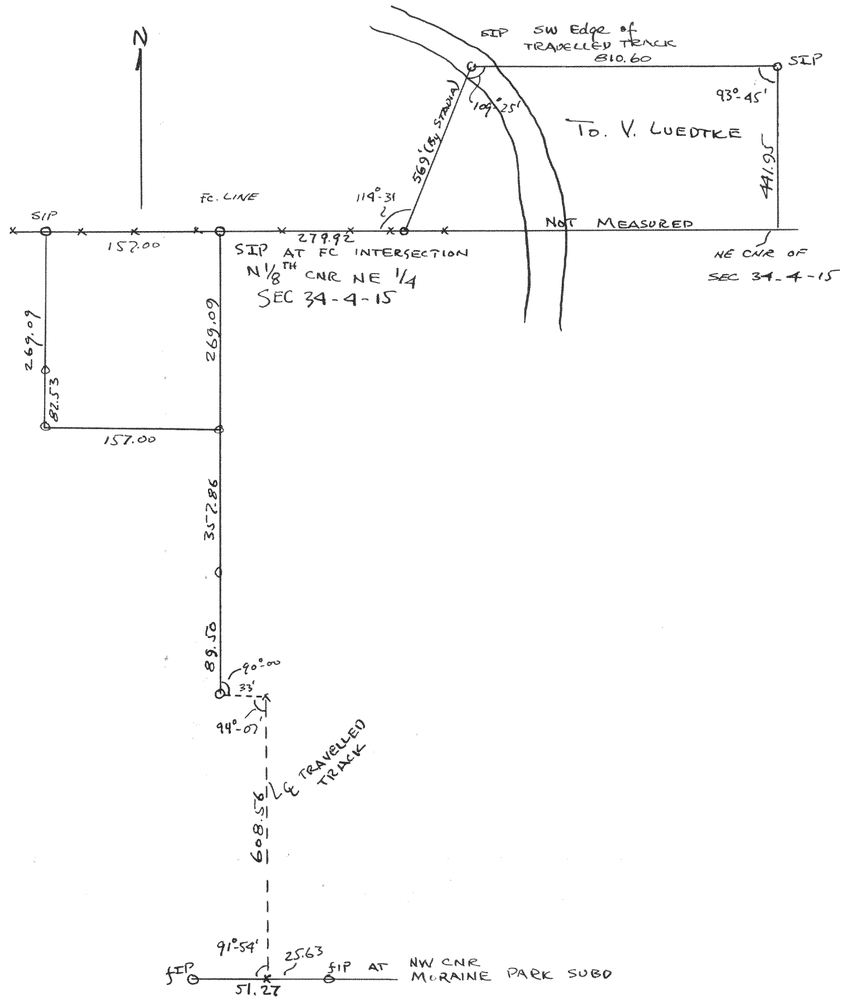

1. Plat of survey of land on Luedtke Farm located in Sections 34 & 27, T4N R15E, Walworth County, Wisconsin
1951

Lloyd L. Jensen JCB
County Surveyor


#2492

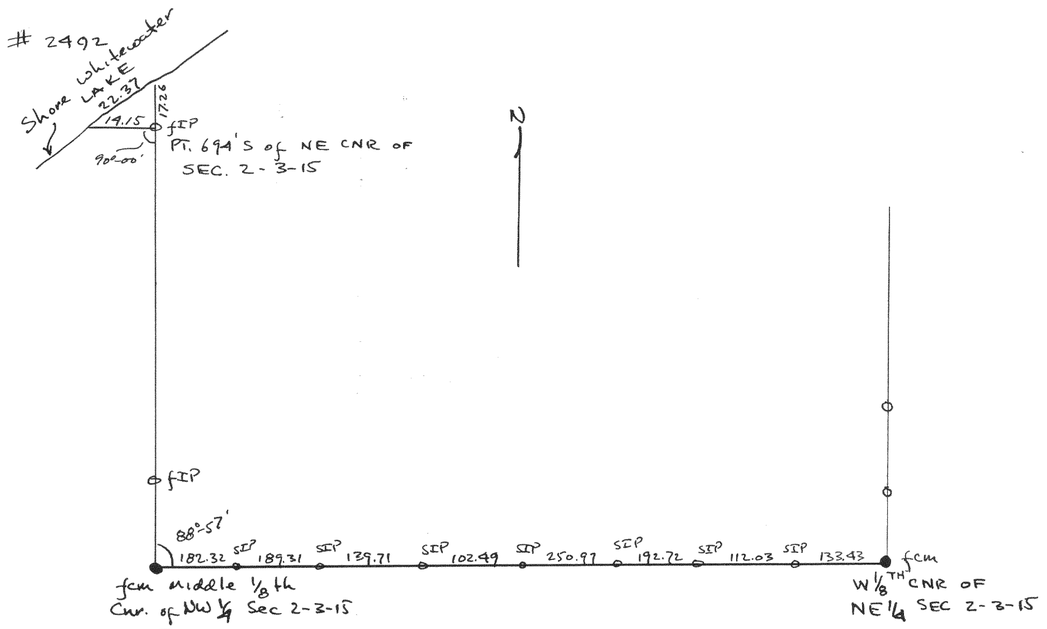

Plat of survey of the South Line of the NE 1/4 of the NW 1/4 of Section 2, T3N R15E of Walworth County, Wisconsin
1951

Lloyd L. Jensen JCB
County Surveyor

#2493

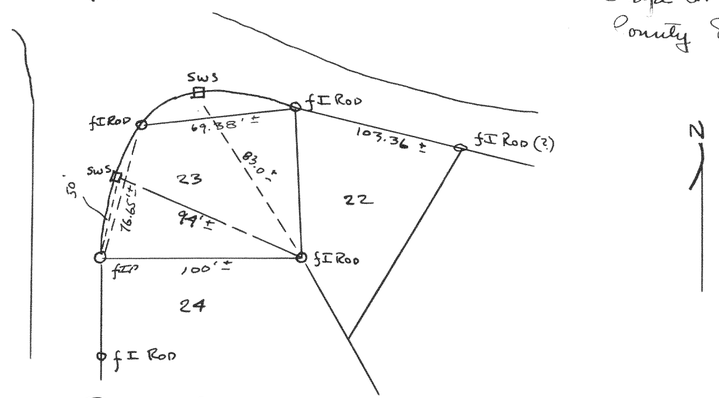

Plat of Partial Survey of lot 23, Block 6, Crystal Bowl Subdivision located in Section 12, T3N R15E, Walworth County Wisconsin
Aug 7, 1951

Lloyd L. Jensen JCB
County Surveyor