

#2498

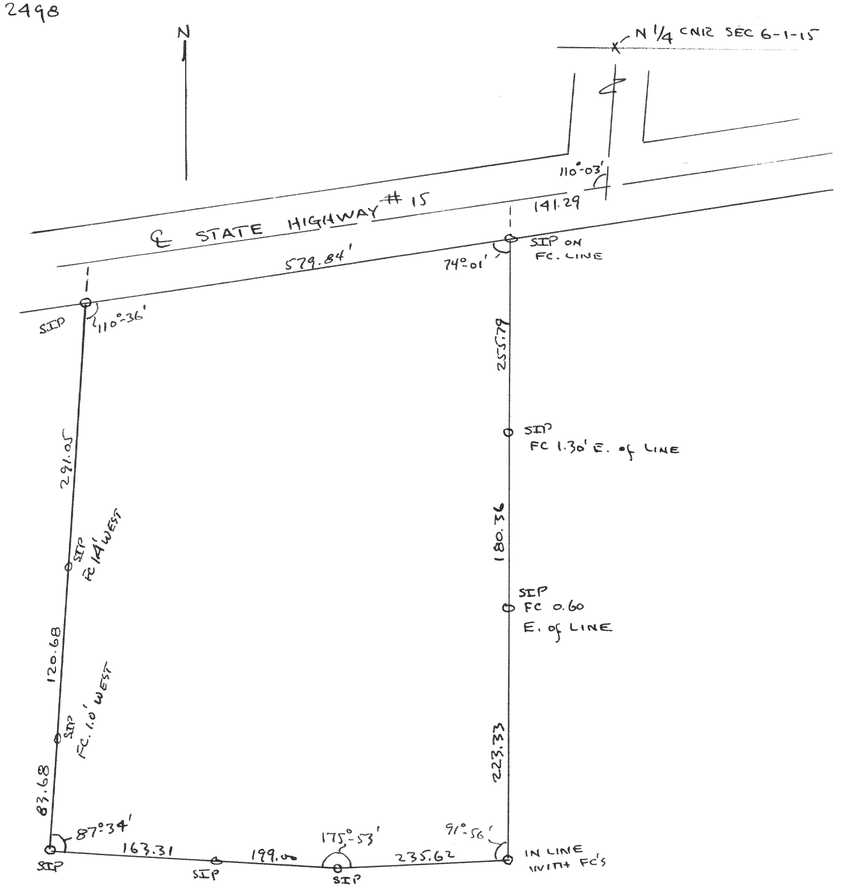

Plat of survey of the Gargus Property located in Allens Grove, Section 6, T1N R15E, Walworth County, Wisconsin
1951

Floyd L. Jensen jeb
County Surveyor

#2499

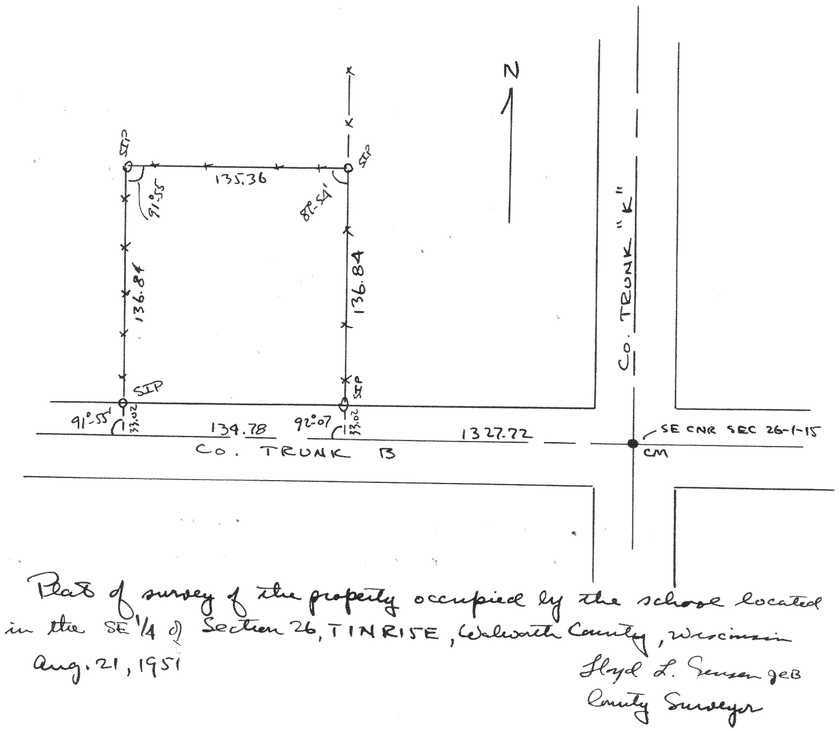

Plat of survey of the property occupied by the school located in the SE 1/4 of Section 26, T1N R15E, Walworth County, Wisconsin
Aug. 21, 1951

Floyd L. Jensen jeb
County Surveyor