
610


2503

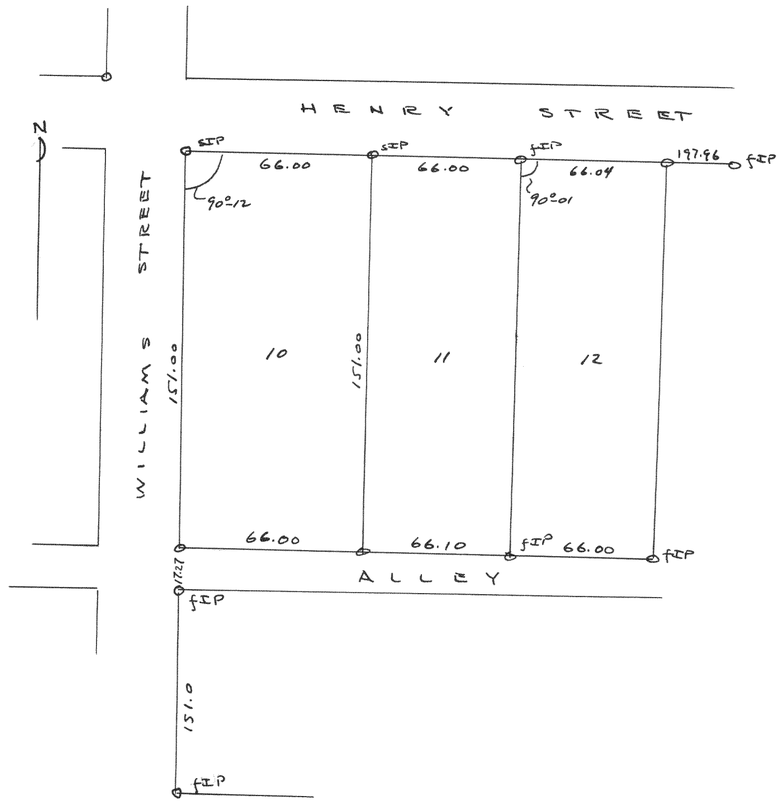

Plat of survey of lot 10, Fergusons addition, Section 25, T2NR17E, City of Lake Geneva, Walworth County, Wis.
March 16, 1951

Lloyd L. Jensen JCD
County Surveyor

2504

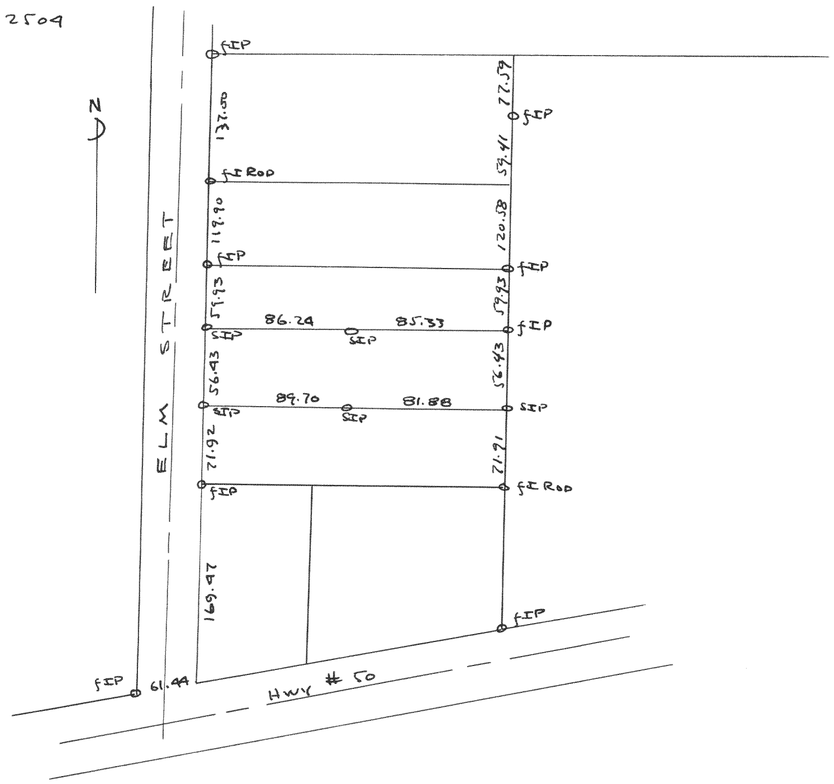

Plat of survey of a parcel of land located on Elm Street in the NE 1/4 of Section 35, T2NR17E, in the City of Lake Geneva, Walworth County, Wisconsin
July 16, 1951

Lloyd L. Jensen JCD
County Surveyor