

2505

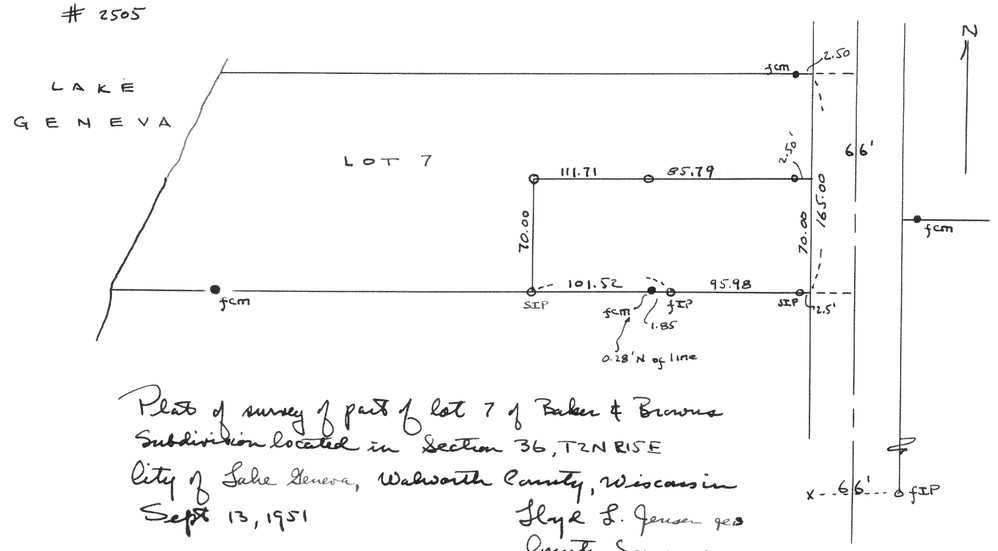

Plat of survey of part of lot 7 of Baker & Browns Subdivision located in Section 36, T2N R15E City of Lake Geneva, Walworth County, Wisconsin
Sept 13, 1951

Floyd L. Jensen JCB
County Surveyor


2506

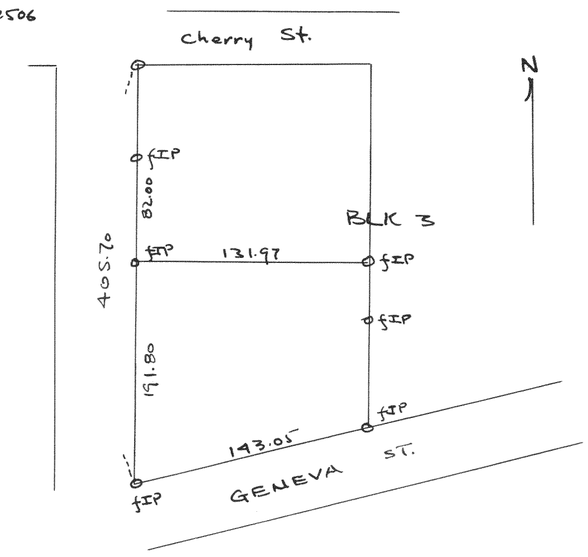

Survey of part of Block 3 of the Original Plat, Village of Williams Bay, Section 1, T1N R16E, Walworth County, Wisconsin
1951

Floyd L. Jensen JCB
County Surveyor


2507

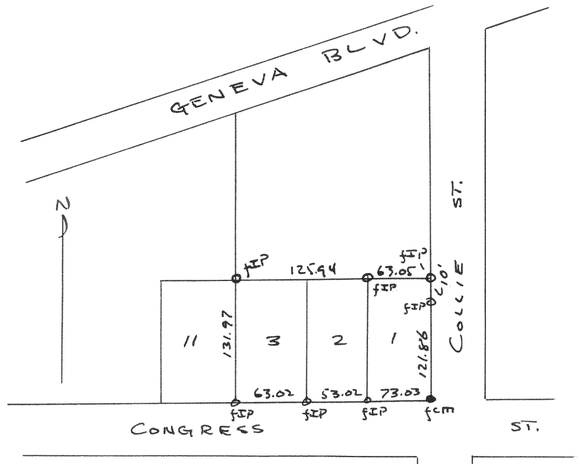

Plat of survey of line between lots 11 & 3 of Madison addition to Williams Bay, Section 1, T1N R16E of Walworth County, Wisconsin
February 26, 1951

Floyd L. Jensen JCB
County Surveyor

2508

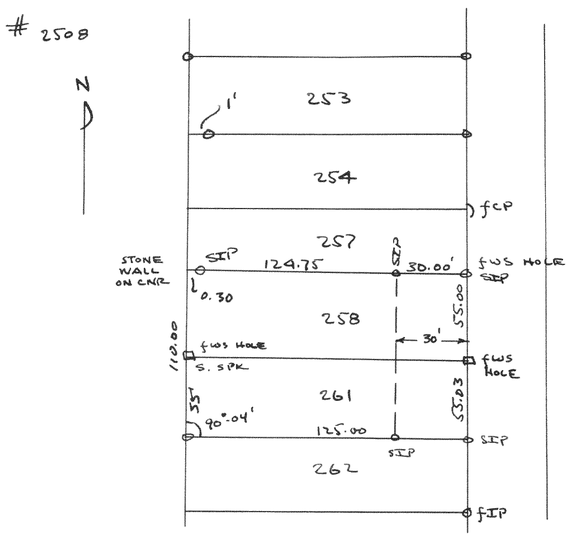

Plat of survey of lots 258, 261 Cedar Point Park 3rd add. to Village of Williams Bay, Section 6, T1N R17E, Walworth County, Wisconsin
March 19, 1951

Floyd L. Jensen JCB
County Surveyor