

#2513

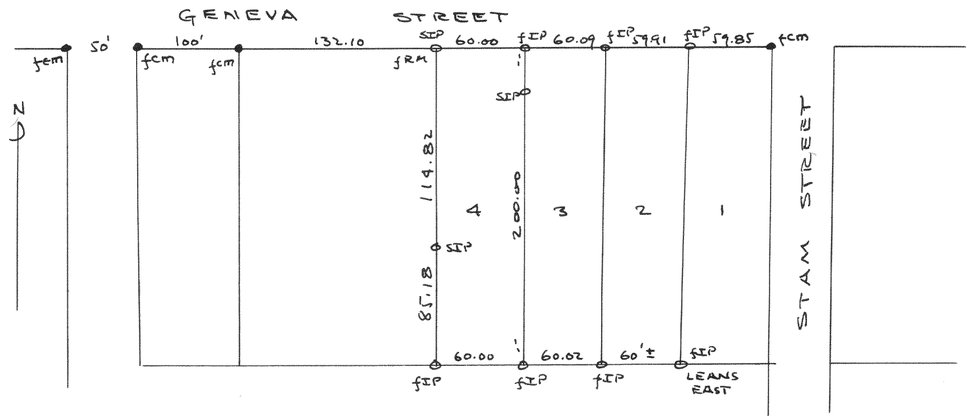

Plat of survey of lot 4, Wm. Pearsons Subdivision, Village of Williams Bay, Section 1, T1NR16E, Walworth County, Wisconsin
July 10, 1951

Lloyd L. Jensen JCB
County Surveyor


#2514

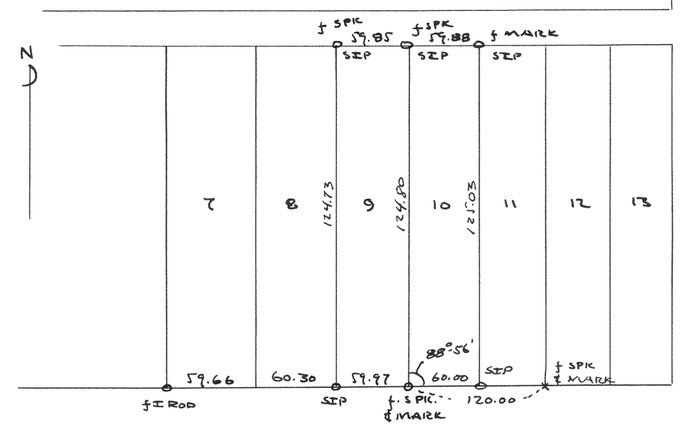

Plat of survey of lots 9 & 10, Lackey Bros. Subdivision, Village of Williams Bay, Section 1, T1NR16E, Walworth County, Wisconsin
July 20, 1951

Lloyd L. Jensen JCB
County Surveyor


#2515

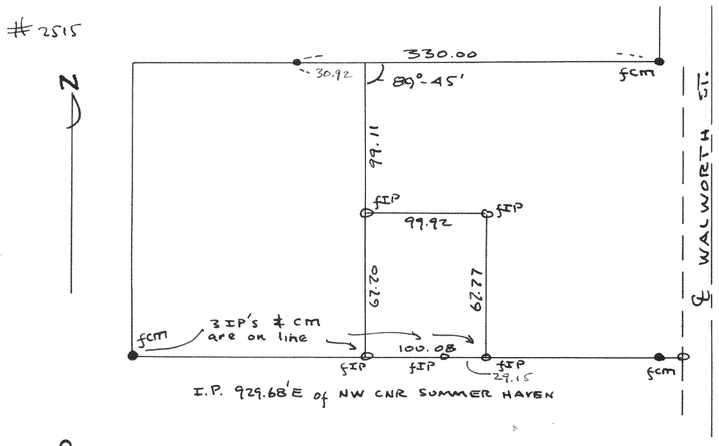

Plat of survey of a parcel of land out of Hatch Estate located in SE 1/4 of Section 1, T1NR16E, Village of Williams Bay, Walworth County, Wis.
Aug 6, 1951

Lloyd L. Jensen JCB
County Surveyor

#2516

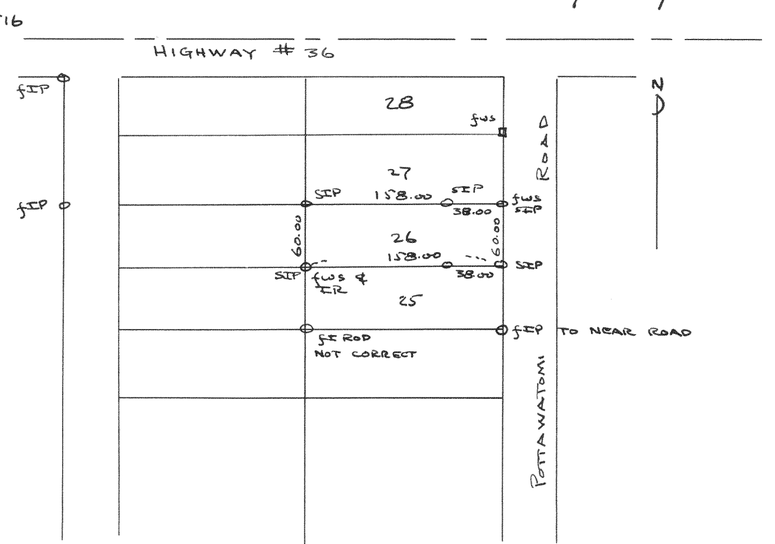

Plat of survey of lot 26, Block 2, Harbor View Subdivision Village of Williams Bay, Section 6, T1NR17E, Walworth County, Wis
Aug. 20, 1951

Lloyd L. Jensen JCB
County Surveyor