

614

2517

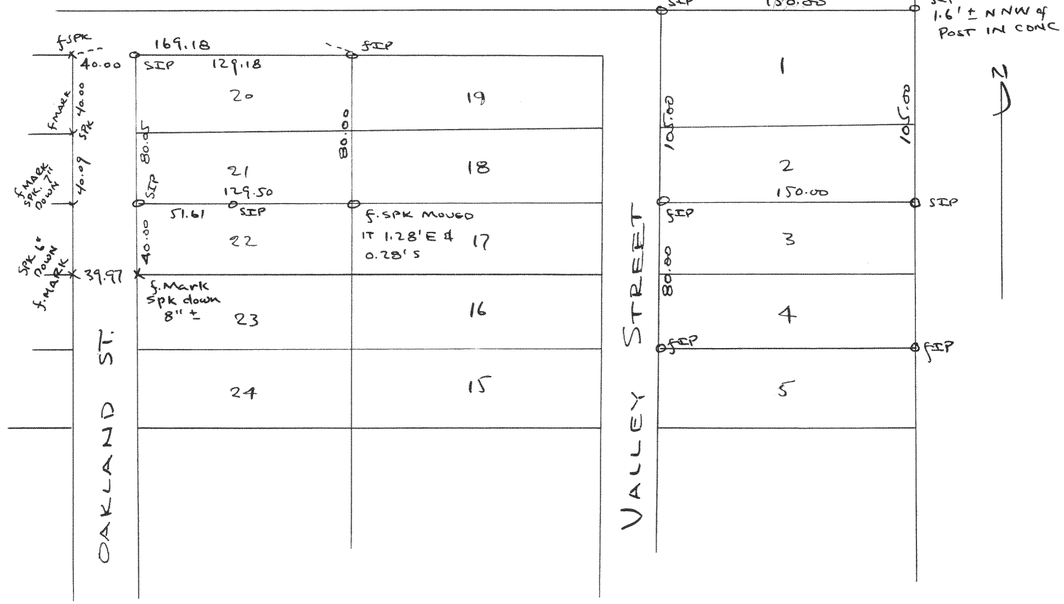


Plat of survey of lots 20 & 21, 1 & 2 of Carlsons Addition, Village of Williams Bay, Section 1, T1N R16E, Walworth County, Wisconsin
Sept 21, 1951
Floyd L. Jensen RLS
County Surveyor

2518

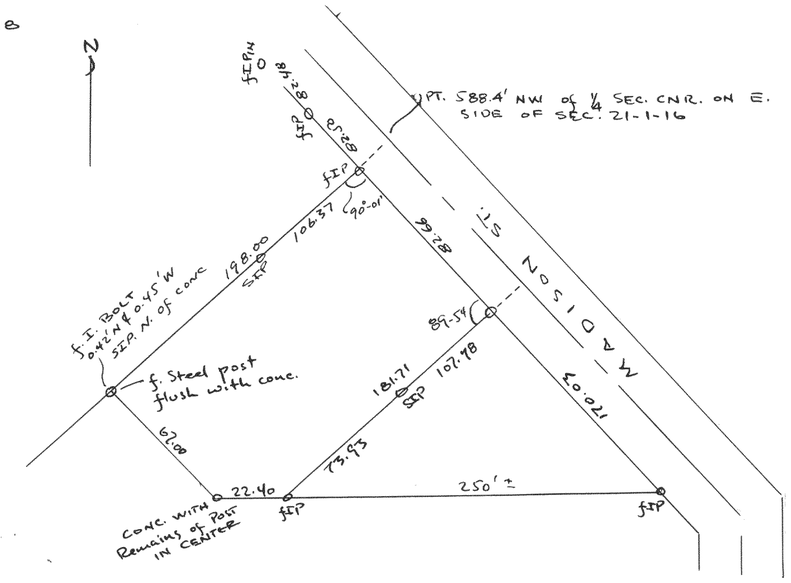

Plat of survey of the Standard Oil Station located in the NE 1/4 of Section 21, T1N R16E, Village of Walworth, Walworth County, Wisconsin
June 9, 1951
Floyd L. Jensen RLS
County Surveyor

2519

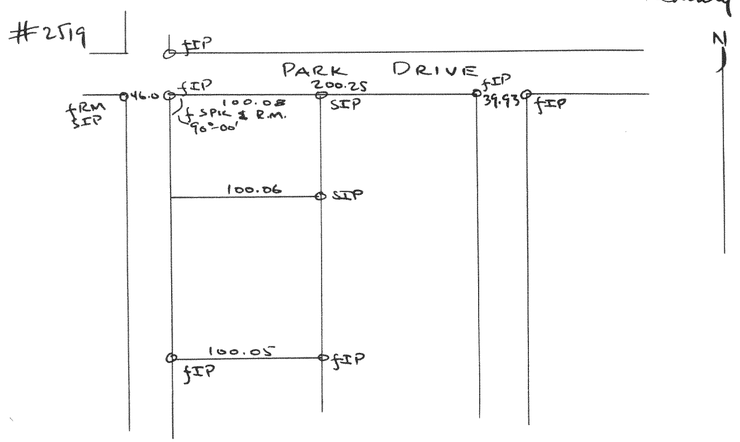

Plat of survey of lots 3073-3077, Lake Como Beach Subdivision T2N R17E, Walworth County, Wisconsin
1951
Floyd L. Jensen RLS
County Surveyor