

2520

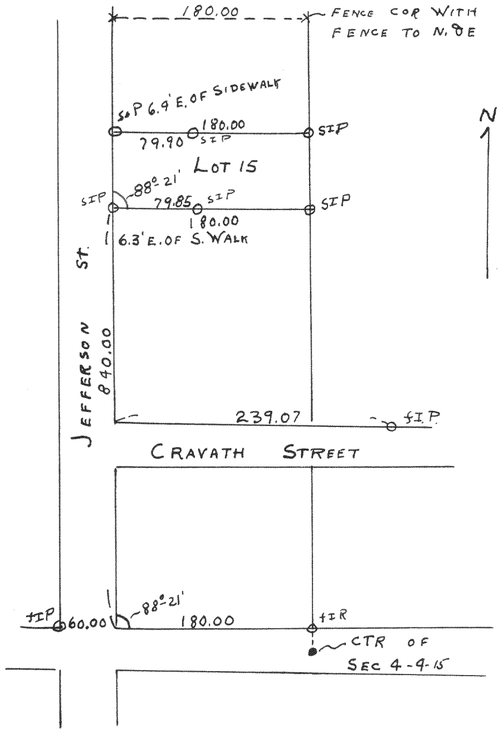

Plat of survey of lot 15 Wilsons Addition to City of Whitewater Section 4 T4 NR15E Walworth County, Wisconsin
June 22, 1951

Floyd L Jensen
County Surveyor

2521

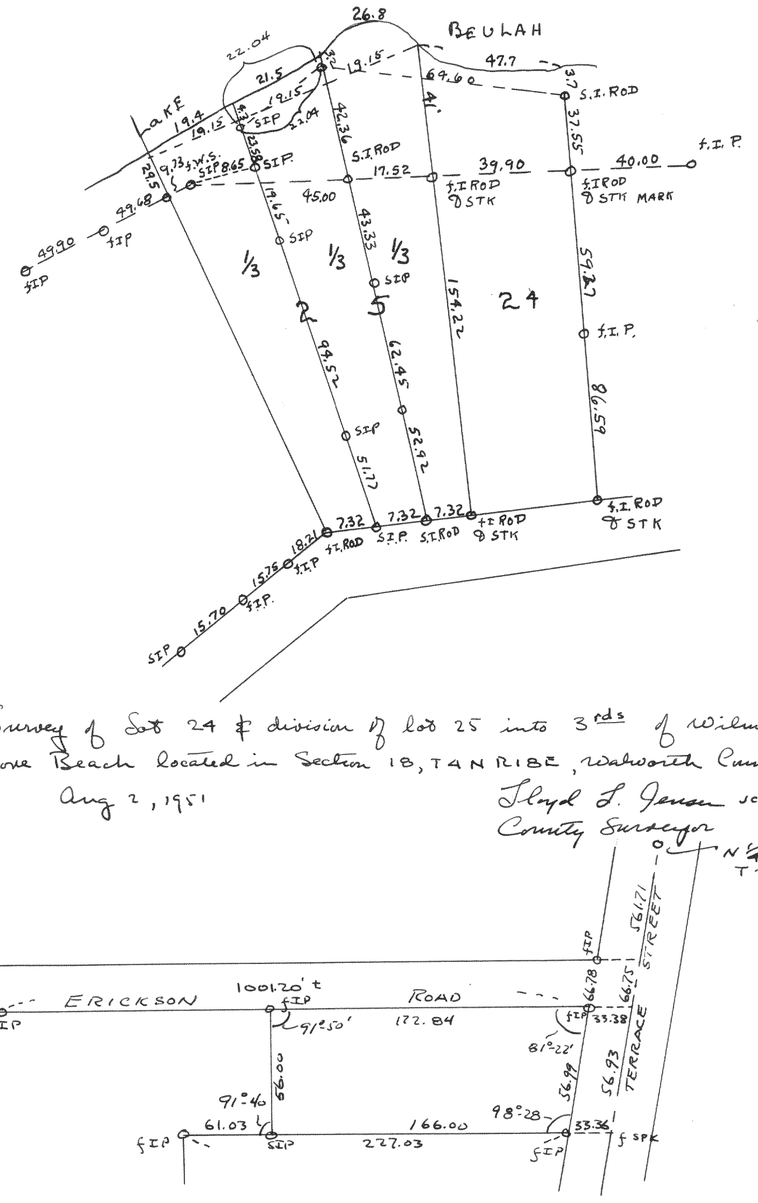

Plat of Survey of Lot 24 & division of lot 25 into 3rds of Wilmers Grove Beach located in Section 18, T4N R18E, Walworth County, Wis.
Aug 2, 1951

Floyd L. Jensen JCB
County Surveyor

2522

Plat of survey of Marina House located in NW¼ of Section 18, T2N R16E, City of Delavan, Walworth County, Wisconsin
Dec. 29, 1951

Floyd L. Jensen 203
County Surveyor