

2523

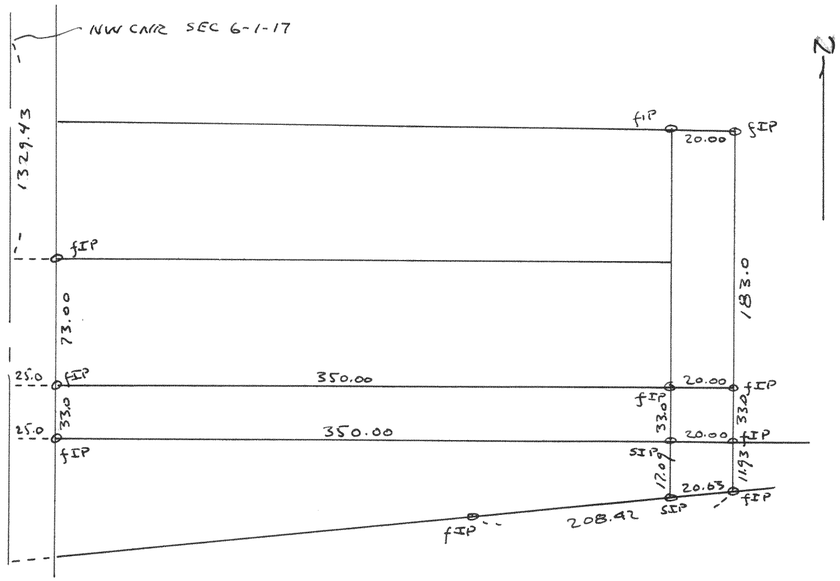

Plat of survey of land south of Globe Marine Co. located in NW 1/4 Section 6, T1N R17E, Walworth County, Wisconsin
Dec. 28, 1951

Lloyd L. Jensen JCB
County Surveyor


2524

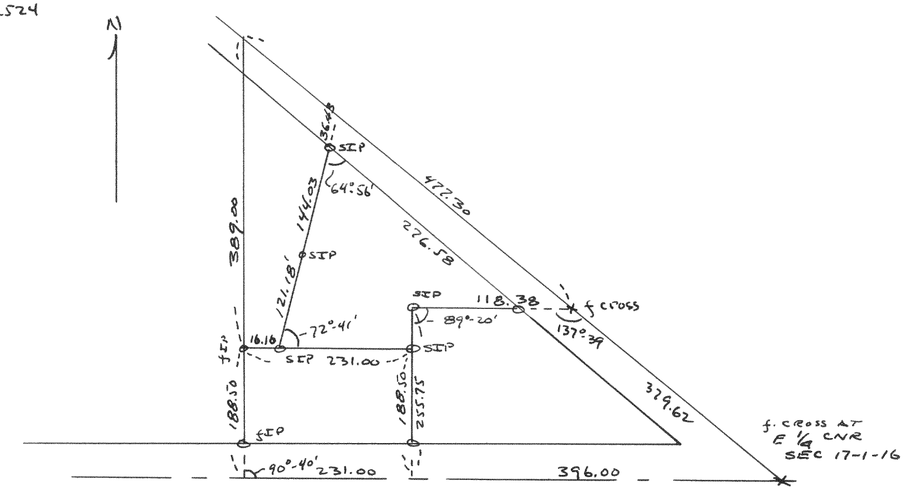

Plat of survey of land at Six Corners Northwest of Walworth located in Section 17, T1N R16E, Walworth County, Wis.
1951

Lloyd L. Jensen JCB
County Surveyor

2525

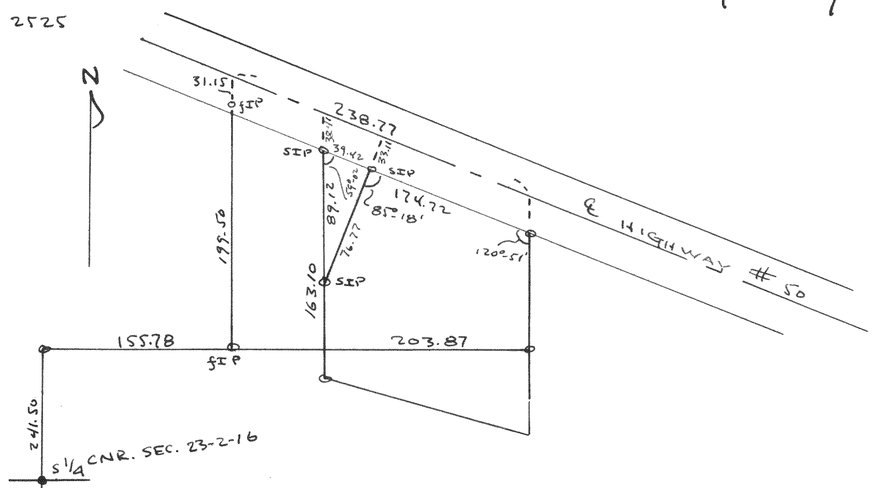

Plat of description of Kent property located in the SE 1/4 of Section 23, T2N R16E of Walworth County, Wisconsin
1951

Lloyd L. Jensen JCB
County Surveyor

2526

Plat of Trinke Estates in Section 10, T1N R17E, Walworth County, Wisconsin - See recorded plat on file in the Register of Deeds office at the County Courthouse
1951

Lloyd L. Jensen JCB
County Surveyor