2531

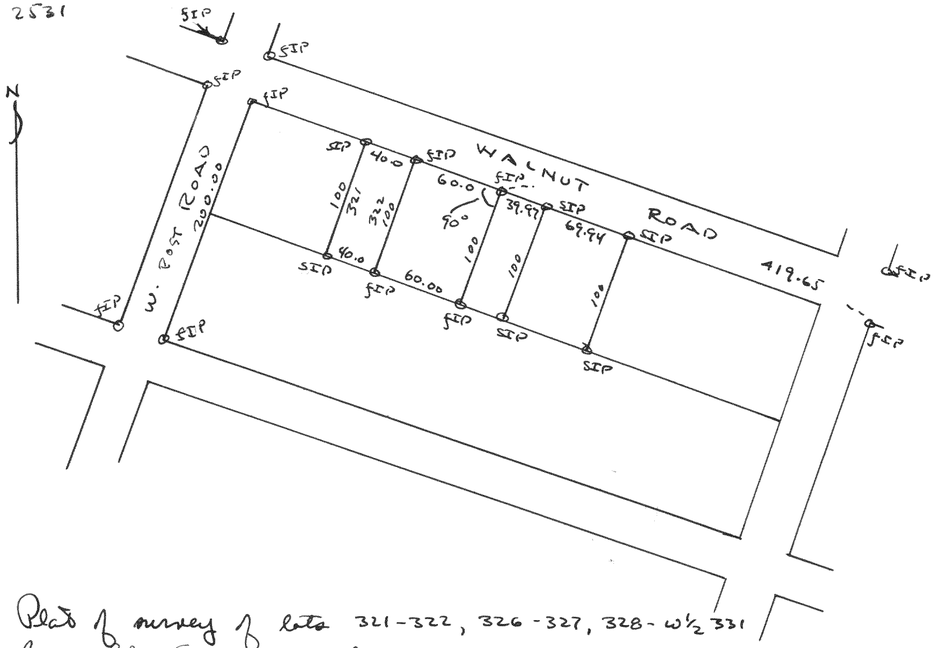

Plat of survey of lots 321-322, 326-327, 328-W½ 331
Bell Lake Subdivision located in T1N R18E, Walworth County, Wisconsin
1951

Lloyd L. Jensen JCB
County Surveyor

2532

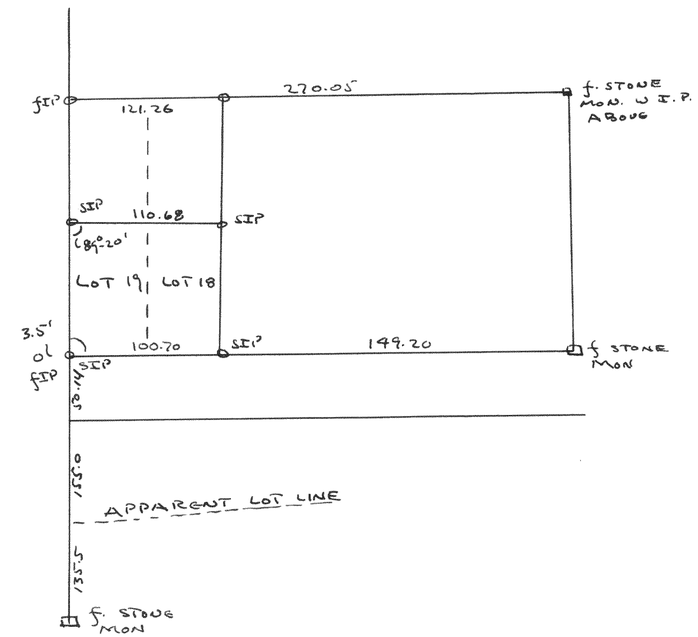

Plat of survey of lots 18 & 19 of Wm Elliotts Subdivision
in Section 13, T1N R18E, Walworth County, Wisconsin
May 11, 1951

Lloyd L. Jensen JCB
County Surveyor

2533

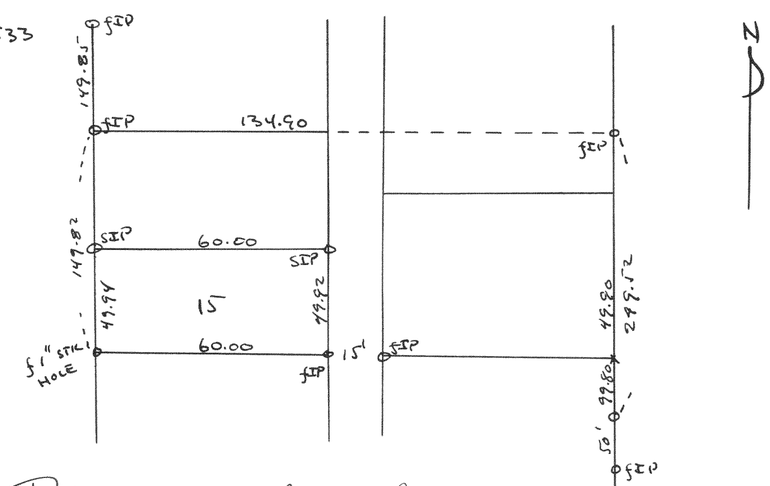

Plat of survey of Lot 15 Camp Sybil located in Section 18, T1N R17E,
Walworth County, Wisconsin
May 25, 1951

Lloyd L. Jensen JCB
County Surveyor

2534

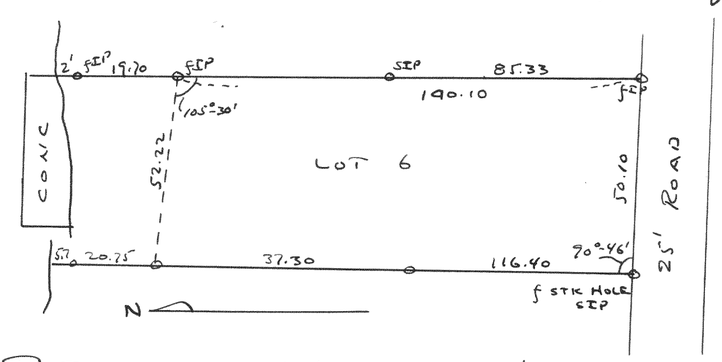

Plat of survey of lot 6 of Edgewater Terrace located in
Section 9, T1N R17E, Walworth County, Wisconsin
1951

Lloyd L. Jensen JCB
County Surveyor