
622


#2542

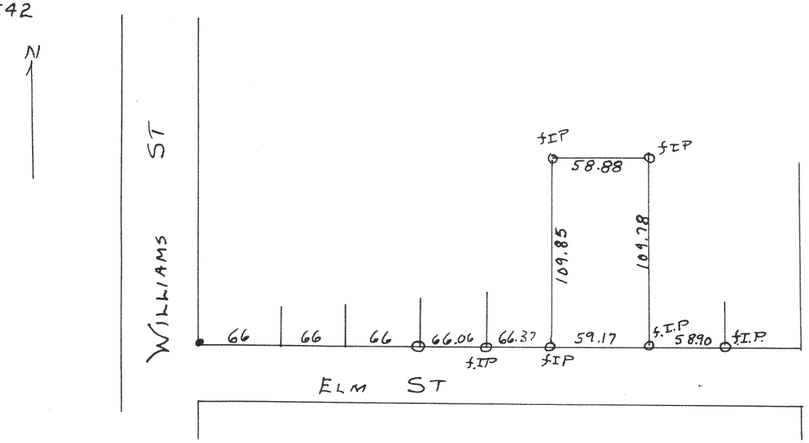

Plat of survey land located in Lot 1 Block 4 of the Original plat of Village of Williams Bay Section 1 T1N R16E, Walworth County, Wis
1951

Lloyd S Jensen
County Surveyor

#2544

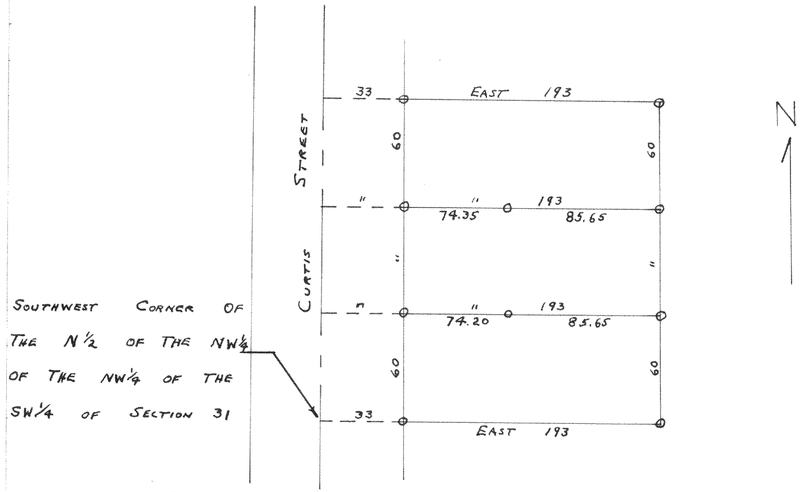


PLAT OF SURVEY OF LAND LOCATED IN THE NORTH ½ OF THE NORTHWEST ¼ OF THE NORTHWEST ¼ OF THE SOUTHWEST ¼ OF SECTION 31, T2N, R18E OF WALWORTH COUNTY, WISCONSIN.
DEC. 1952

Lloyd R. Jensen SA
COUNTY SURVEYOR

Paid to her March 25, 1952


#2543

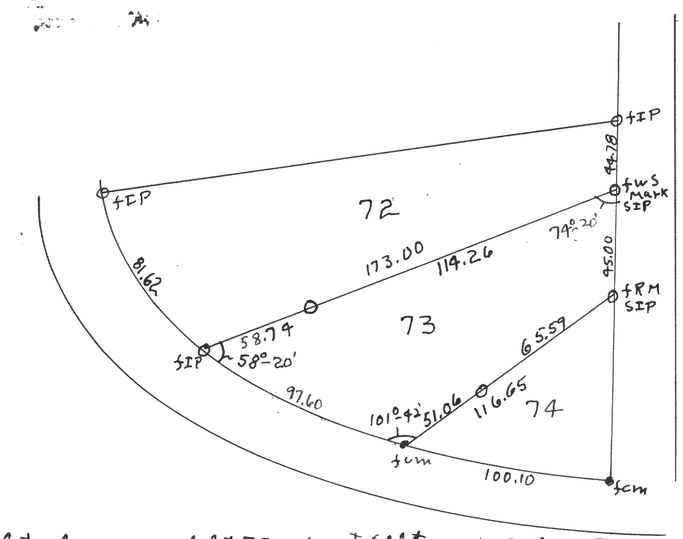

Plat of survey of lot 73 of 1st addition to Cedar Point Park located in Section 6 T1N R17E, Village of Williams Bay
Walworth County, Wisconsin
May 8, 1951

Lloyd S Jensen
County Surveyor

#2545

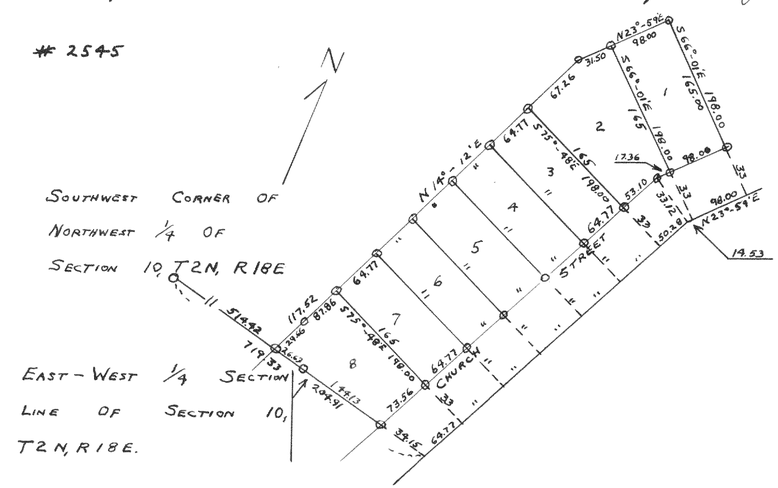

PLAT OF A SURVEY OF LAND LOCATED IN THE NORTHWEST ¼ OF SECTION 10, T2N, R18E OF WALWORTH COUNTY, WISCONSIN.
JULY 1952

Lloyd R. Jensen SA
COUNTY SURVEYOR