
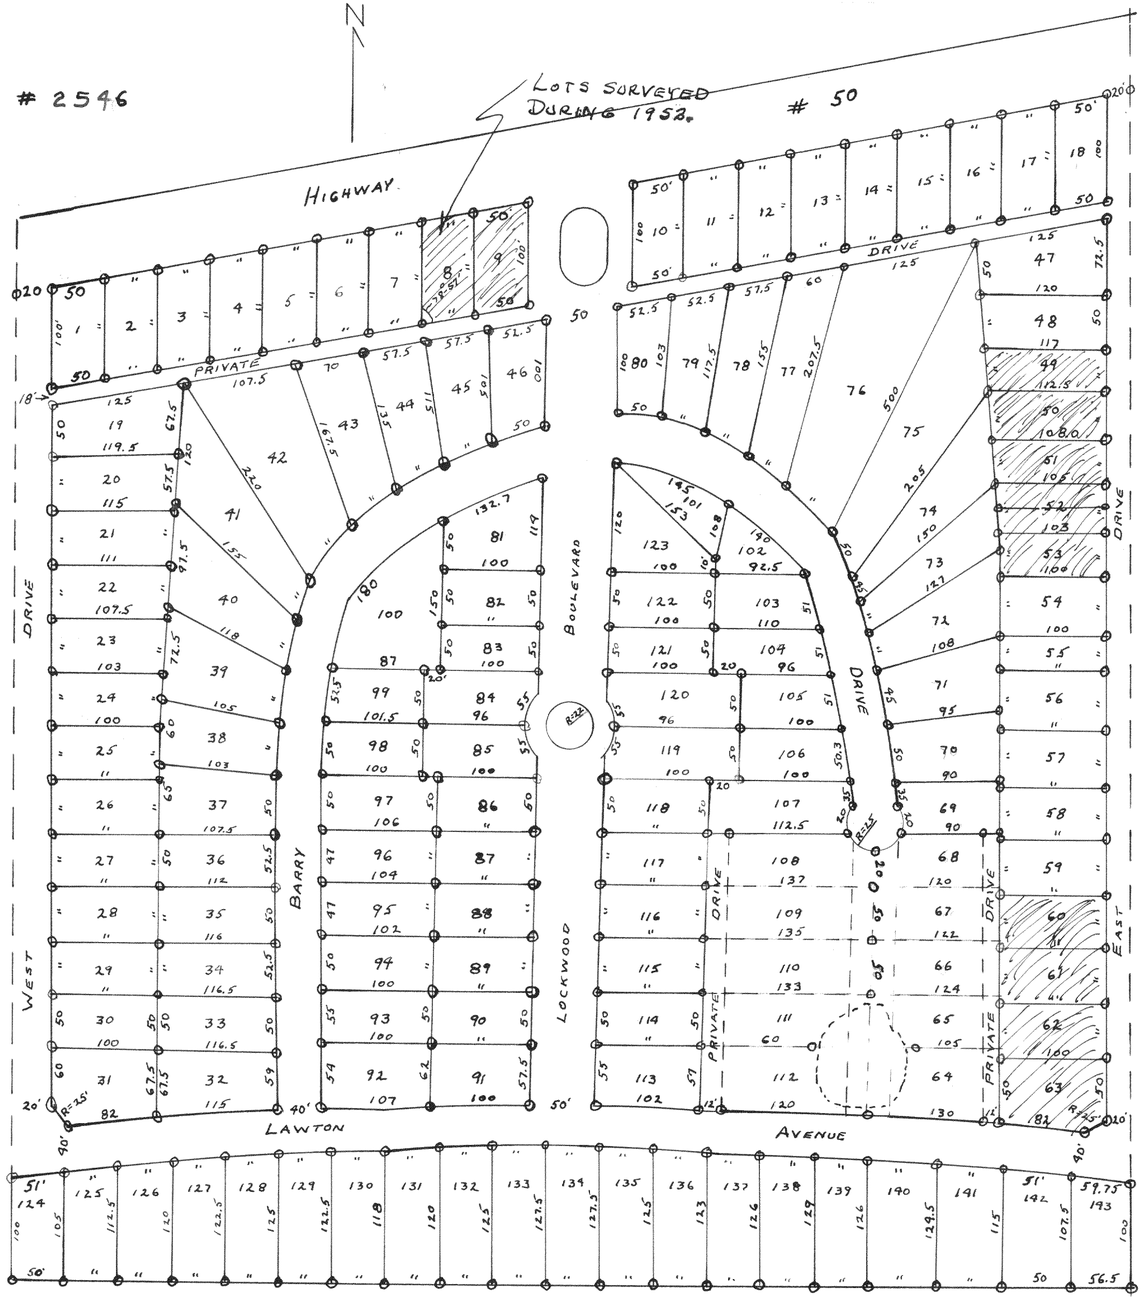



PLAT OF A SURVEY OF GOLF HILLS SUBDIVISION WHICH LAND LIES IN SECTION 31, T 2 N, R 18 E WALWORTH COUNTY WISCONSIN 1952

Lloyd L. Jensen SA
COUNTY SURVEYOR

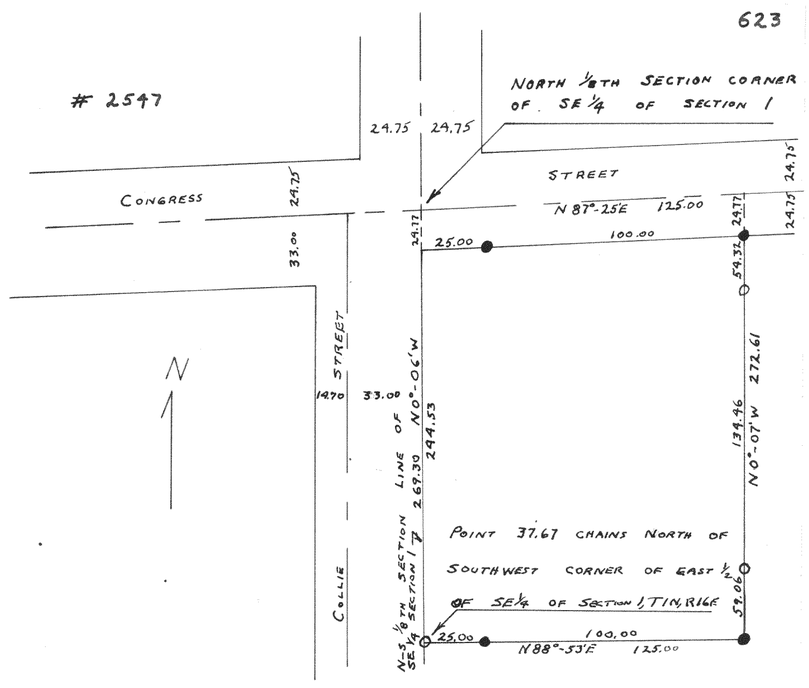

PLAT OF SURVEY OF LAND LOCATED IN THE NE 1/4 OF THE SE 1/4 OF SECTION 1, T 1N, R 16 E, VILLAGE OF WILLIAMS BAY, WALWORTH COUNTY, WISCONSIN.
DECEMBER 1951

Lloyd L. Jensen SA
COUNTY SURVEYOR

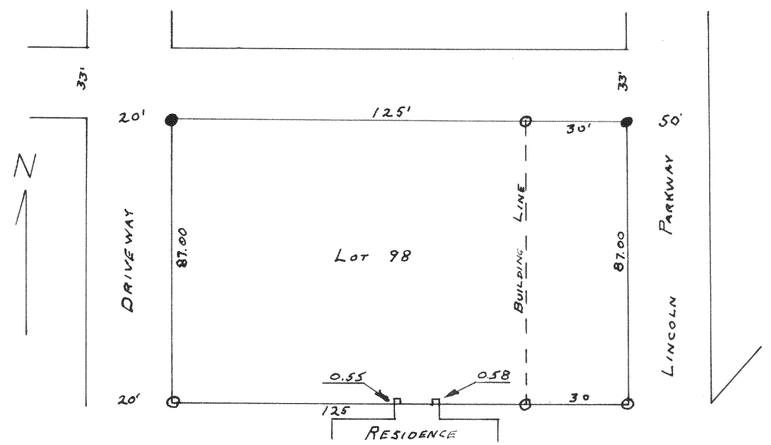

PLAT OF SURVEY OF LOT 98 OF THE ORIGINAL CEDAR POINT PARK SUBDIVISION IN THE VILLAGE OF WILLIAMS BAY WALWORTH COUNTY WISCONSIN
OCTOBER 24, 1951

Lloyd L. Jensen SA
COUNTY SURVEYOR