
628


2557

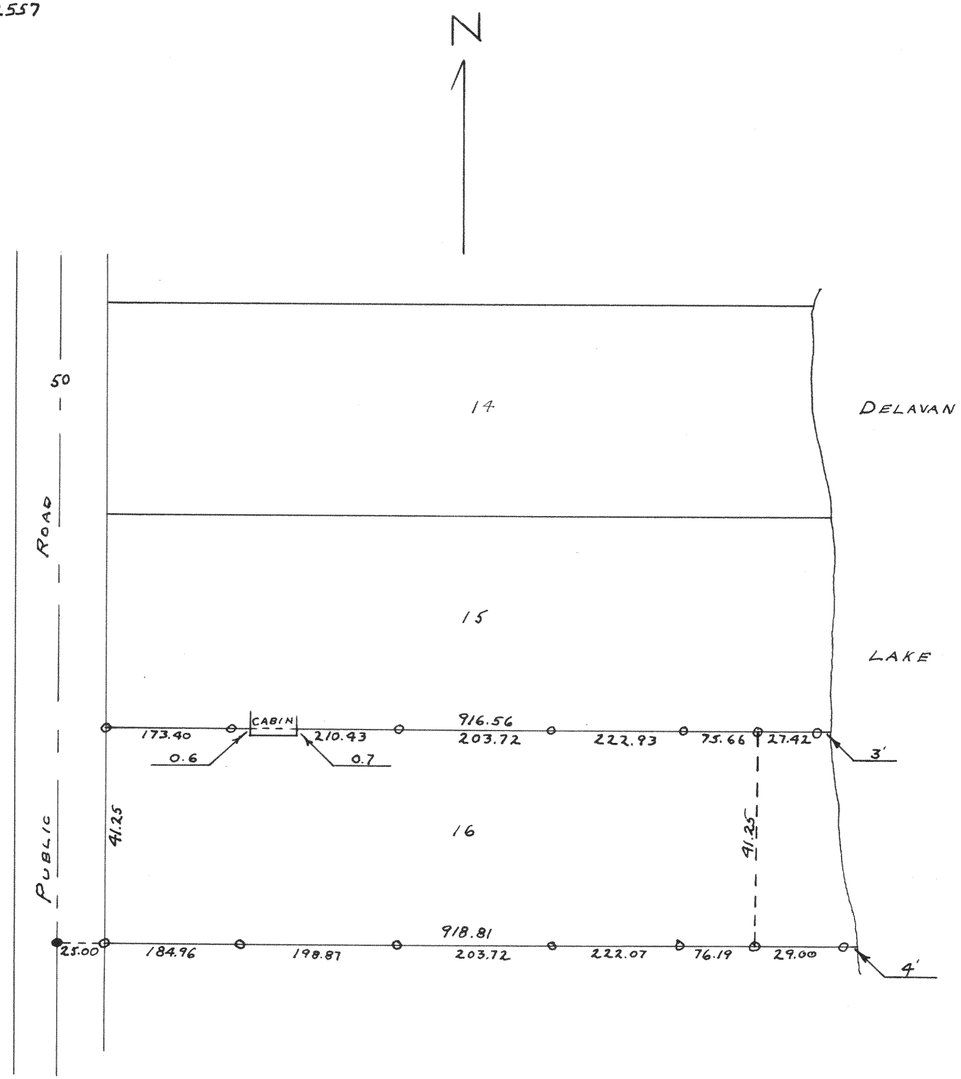

PLAT OF A SURVEY OF LOT 16 OF STROW PARK SUBDIVISION, LOCATED IN SECTION 28, T2N, R16E OF WALWORTH COUNTY, WISCONSIN.
JULY 1952

Lloyd L. Jensen SA
COUNTY SURVEYOR

2558

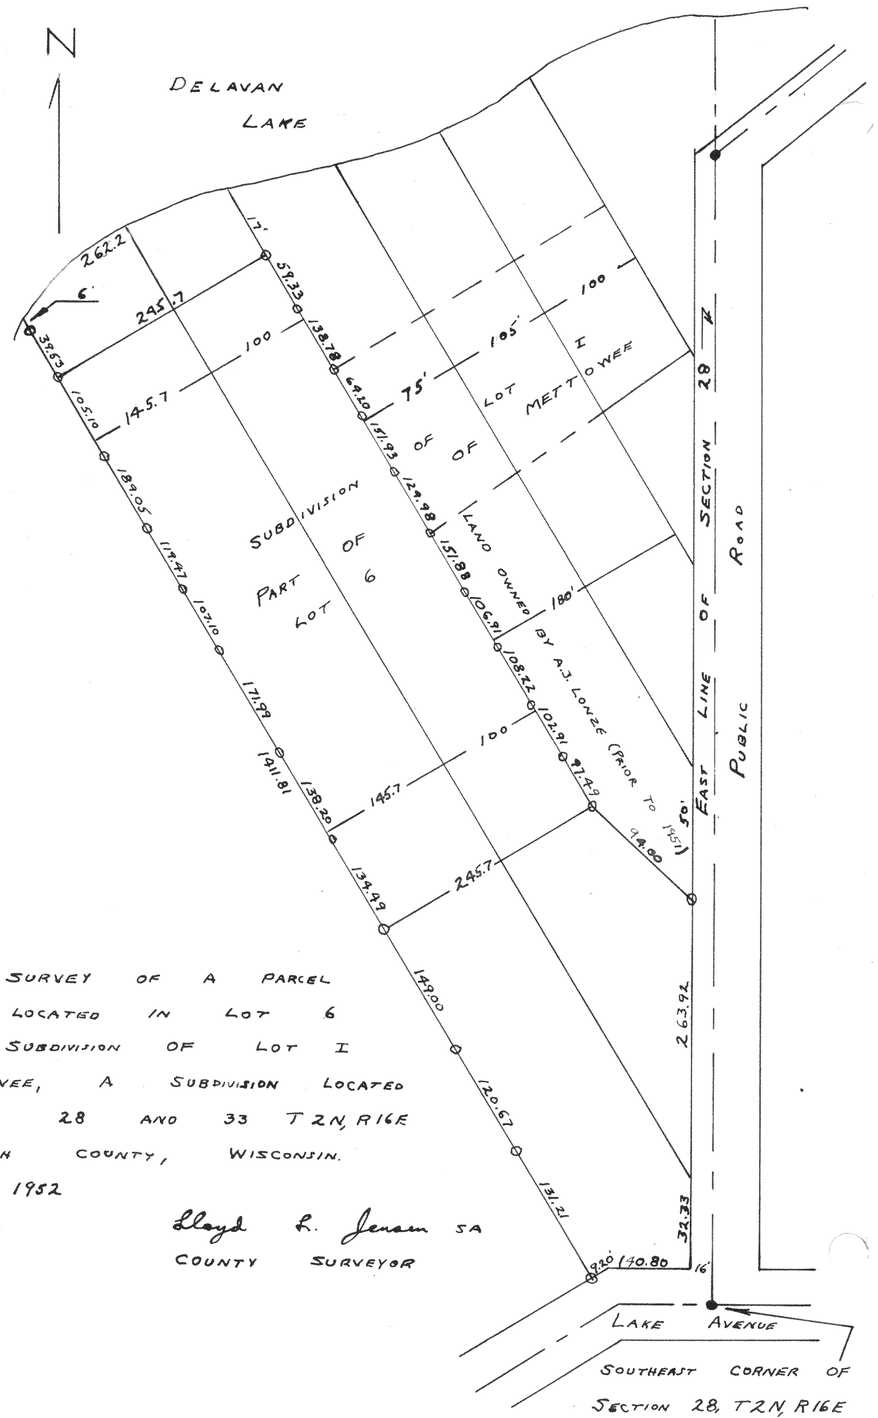

PLAT OF SURVEY OF A PARCEL OF LAND LOCATED IN LOT 6 OF THE SUBDIVISION OF LOT I OF METTOWEE, A SUBDIVISION LOCATED IN SECTIONS 28 AND 33 T2N, R16E OF WALWORTH COUNTY, WISCONSIN.
JANUARY 8, 1952

Lloyd L. Jensen SA
COUNTY SURVEYOR