
2559

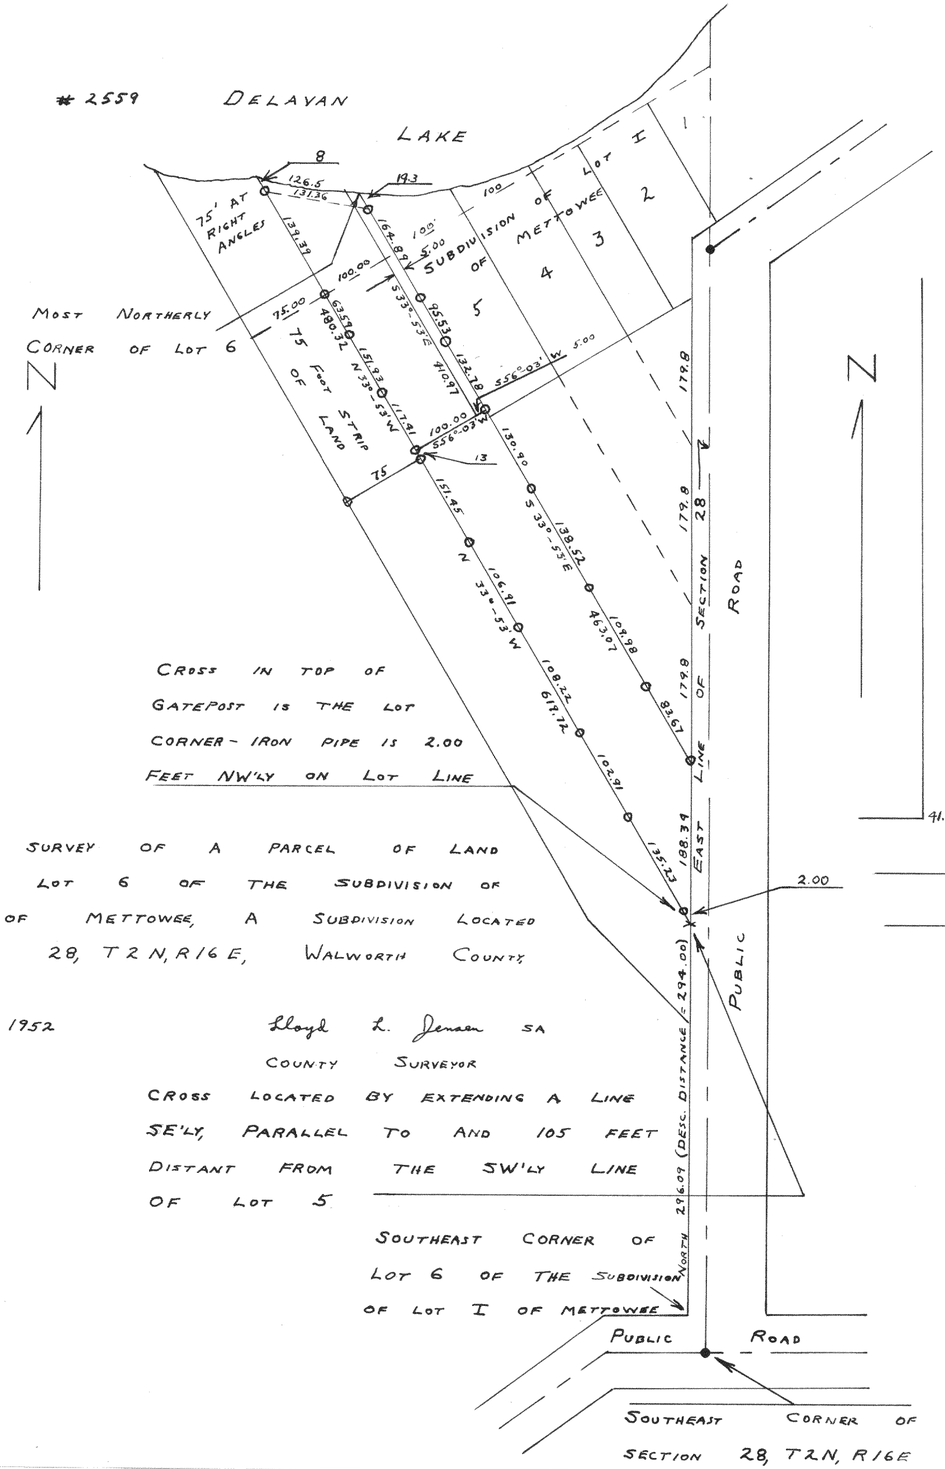

CROSS IN TOP OF GATEPOST IS THE LOT CORNER - IRON PIPE IS 2.00 FEET NW'LY ON LOT LINE


PLAT OF SURVEY OF A PARCEL OF LAND LOCATED IN LOT 6 OF THE SUBDIVISION OF LOT I OF METTOWEE, A SUBDIVISION LOCATED IN SECTION 28, T 2 N, R 16 E, WALWORTH COUNTY, WISCONSIN.

SEPTEMBER 1952

Lloyd L. Jensen SA
COUNTY SURVEYOR

CROSS LOCATED BY EXTENDING A LINE SE'LY, PARALLEL TO AND 105 FEET DISTANT FROM THE SW'LY LINE OF LOT 5

2560

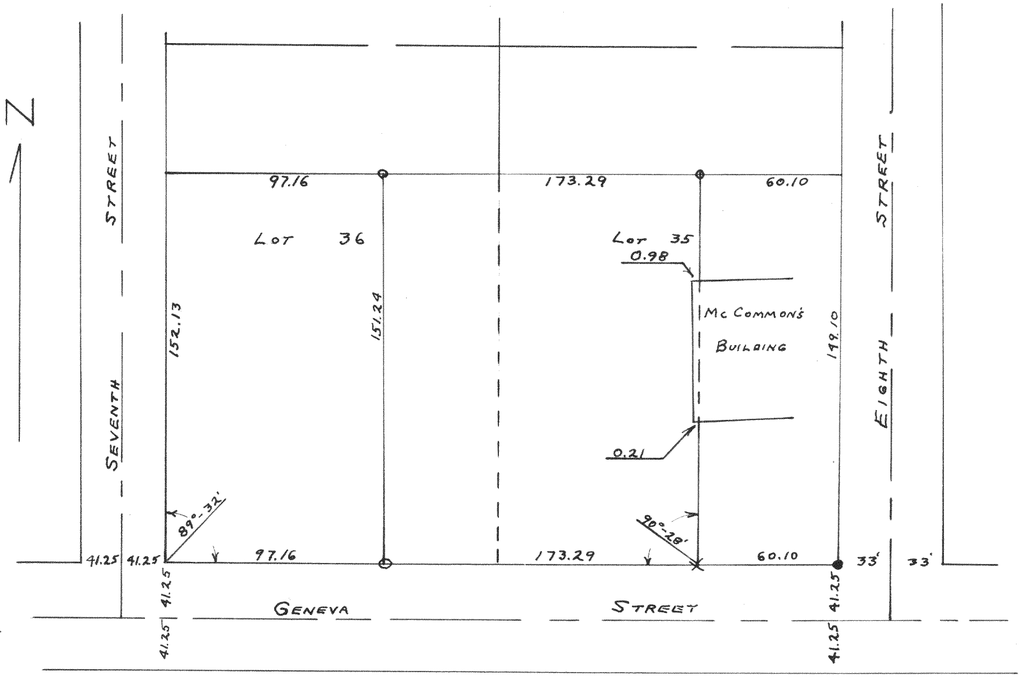

PLAT OF SURVEY OF PART OF LOTS 35 AND 36 BLOCK 13 PASSAGE, ARAM AND DOWNIE ADDITION LYING IN THE CITY OF DELAVAN WALWORTH COUNTY, WISCONSIN.

APRIL 9, 1952

Lloyd L. Jensen SA
COUNTY SURVEYOR