
634


2569

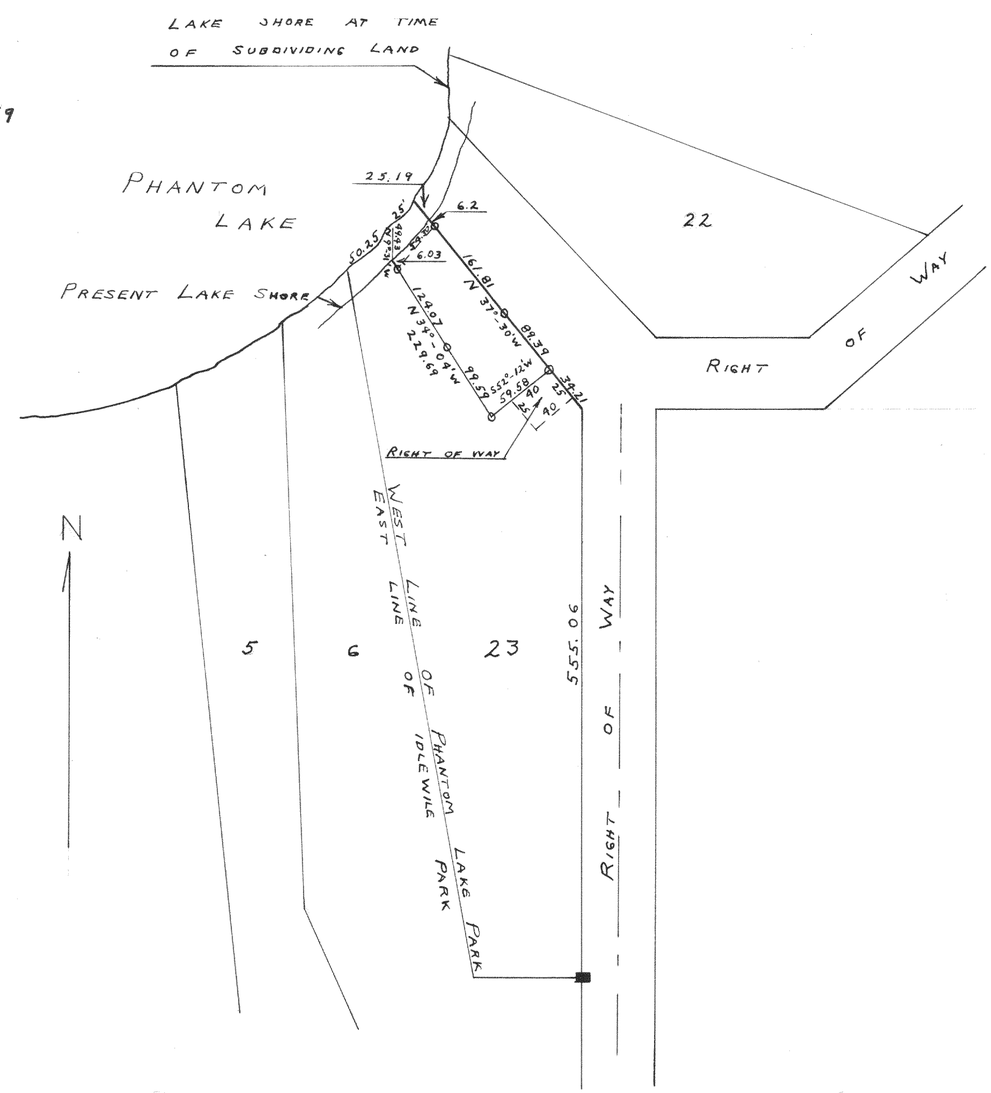

PLAT OF SURVEY OF PART OF LOT 23 OF PHANTOM LAKE PARK LOCATED IN SECTIONS 34 AND 35, T 5 N, R 18 E WAUKESHA COUNTY, WISCONSIN.
FEBRUARY 1952

Lloyd R. Jensen SA
COUNTY SURVEYOR

2570

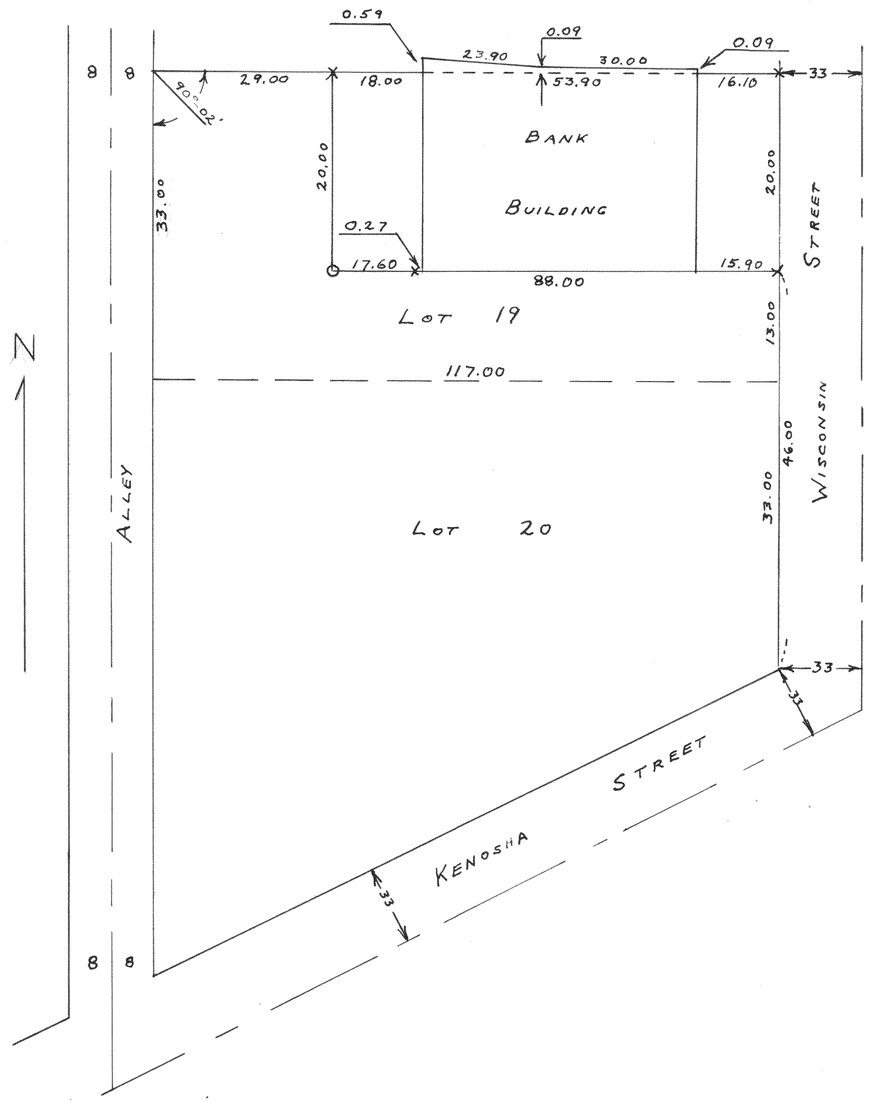

PLAT OF A SURVEY OF THE FARMER'S STATE BANK PROPERTY LOCATED ON LOT 19 BLOCK 22 IN FREY'S ADDITION TO THE VILLAGE OF DARIEN WALWORTH COUNTY, WISCONSIN.
MARCH 31, 1952

Lloyd L. Jensen SA
COUNTY SURVEYOR