

2571

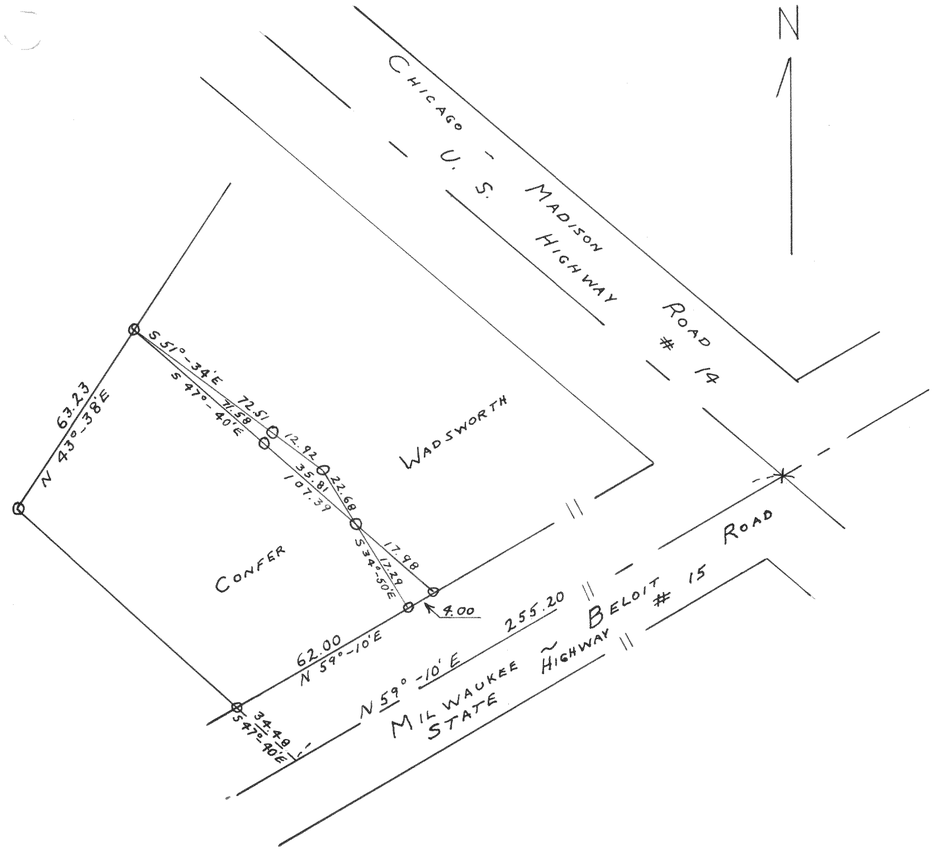

PLAT OF SURVEY OF LAND LOCATED IN THE SOUTHWEST QUARTER OF SECTION 27, T2N, R15E, VILLAGE OF DARIEN WALWORTH COUNTY, WISCONSIN.
JUNE 1952

Lloyd L. Jensen SA
COUNTY SURVEYOR

2572

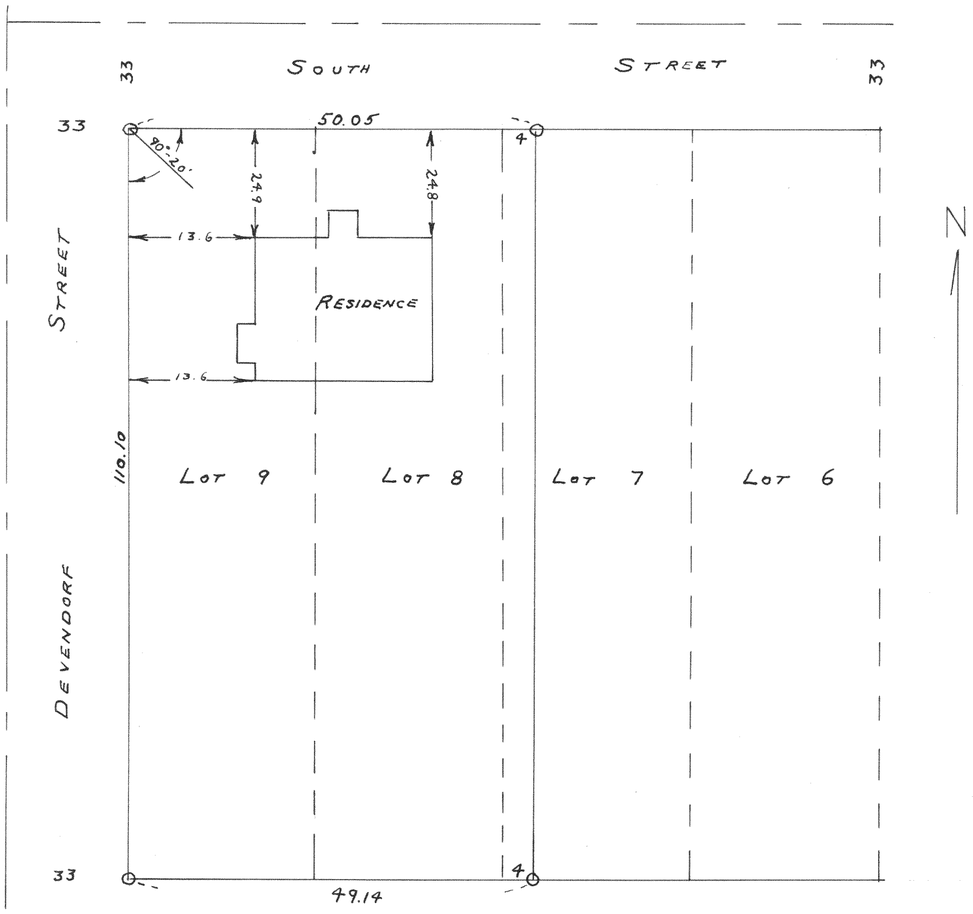

PLAT OF SURVEY OF THE WEST 4' OF LOT 7 AND LOTS 8 AND 9, BLOCK 3 IN ELKHORN GARDENS; LOCATED IN THE CITY OF ELKHORN WALWORTH COUNTY, WISCONSIN.
APRIL 3, 1952

Lloyd L. Jensen SA
COUNTY SURVEYOR