
2573

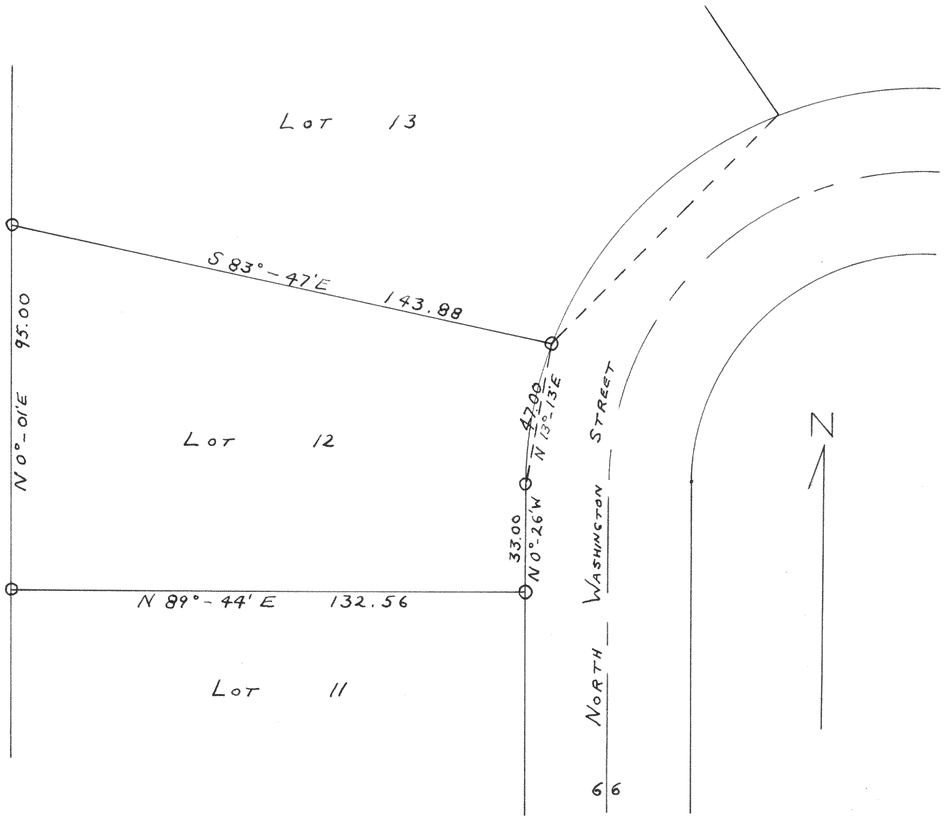

STATE OF WISCONSIN) SS
WALWORTH COUNTY)

I, LLOYD L. JENSEN DO HEREBY CERTIFY THAT I HAVE SURVEYED THE PROPERTY DESCRIBED ACCORDING TO THE OFFICIAL RECORDS AS, LOT 12 MANN BROTHER'S ADDITION, LOCATED IN THE CITY OF ELKHORN WALWORTH COUNTY, WISCONSIN, AND THAT THE PLAT ABOVE IS A CORRECT REPRESENTATION OF THE LOT LINES OF BUILDINGS THEREON.

ELKHORN, WISCONSIN NOV. 10, 1952

Lloyd L. Jensen SA
COUNTY SURVEYOR

2574



STATE OF WISCONSIN) SS
WALWORTH COUNTY)

I, LLOYD L. JENSEN DO HEREBY CERTIFY THAT I HAVE SURVEYED THE PROPERTY SHOWN HEREON, AND THAT THE PLAT ABOVE IS A CORRECT REPRESENTATION OF THE PROPERTY LINES AND PRINCIPAL LINES OF BUILDINGS THEREON.

ELKHORN, WISCONSIN, NOV. 8, 1952

Lloyd L. Jensen SA
COUNTY SURVEYOR