
2575

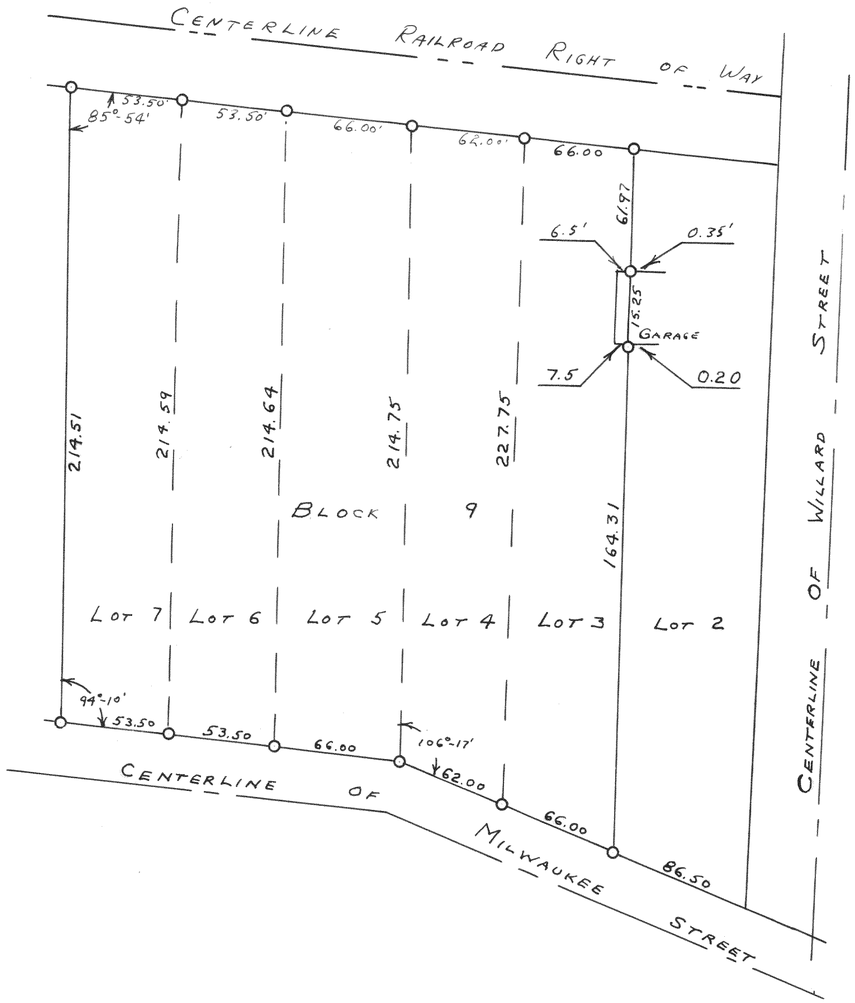


PLAT OF SURVEY OF LOTS 3 TO 7 INCLUSIVE, BLOCK 9 OF S.C. HALL'S TO THE CITY OF WHITEWATER, WALWORTH COUNTY, WISCONSIN

MAY 1952

Lloyd L. Jensen SA
COUNTY SURVEYOR

2576

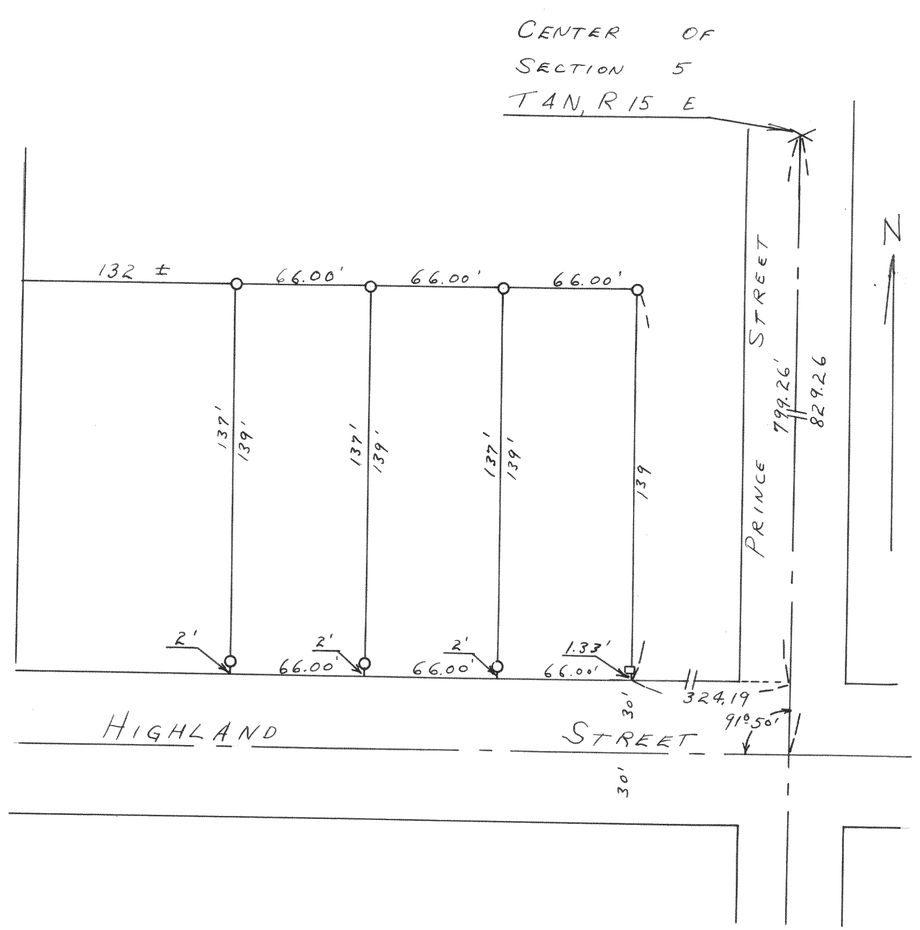

PLAT OF SURVEY OF LAND LOCATED IN THE SOUTHWEST 1/4 OF SECTION 5, T4 N, R 15 E, CITY OF WHITEWATER, WALWORTH COUNTY, WISCONSIN.

APRIL 3, 1952

Lloyd L. Jensen SA
COUNTY SURVEYOR