
2577

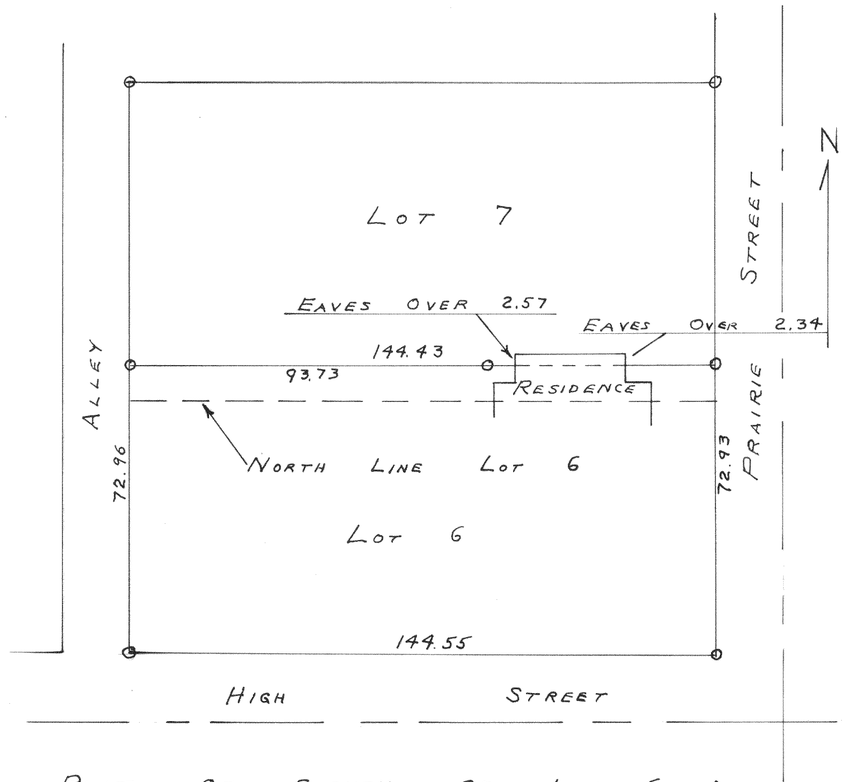


Plat of Survey of Lot 6 and Part of Lot 7 Block 20 Chapman and Ludington's Addition Located in the City of Whitewater Walworth County, Wisconsin.

May 9, 1952

Floyd L. Jensen SA
County Surveyor

2578

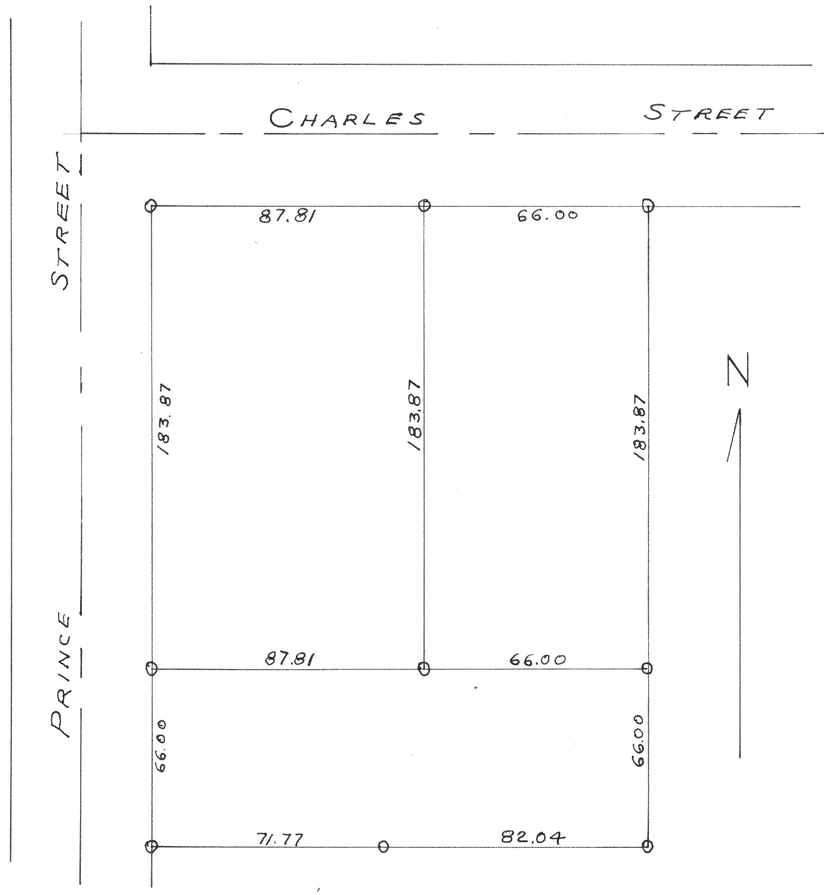

Plat of Survey of Parcels of Land Located in Lot 4, Block 3, Birge's Addition to the City of Whitewater, Walworth County, Wisconsin

April 1952

Floyd L. Jensen SA
County Surveyor