
2583

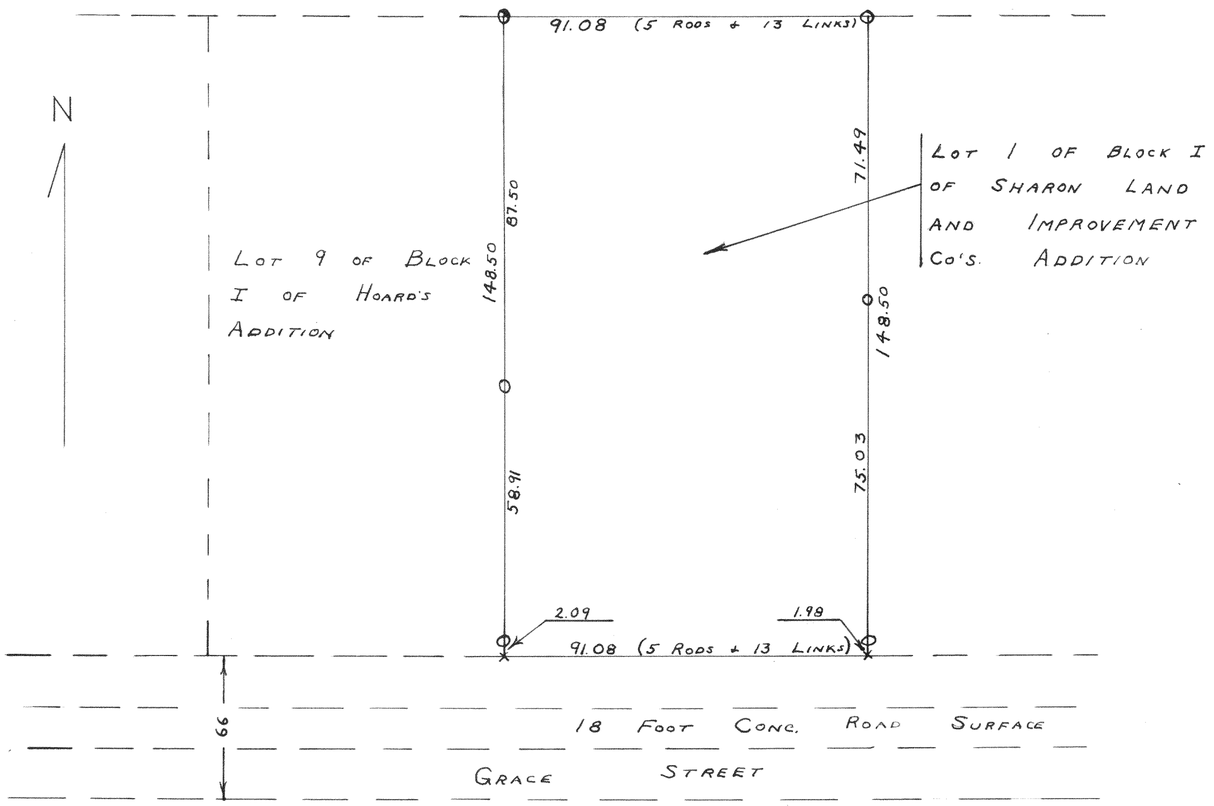


Plat Of Survey Of Lot 1 Of Block I Of Sharon Land And Improvement Company's Addition To The Village Of Sharon, Walworth County, Wisconsin.

July 1952

Lloyd L. Jensen SA
County Surveyor

2584

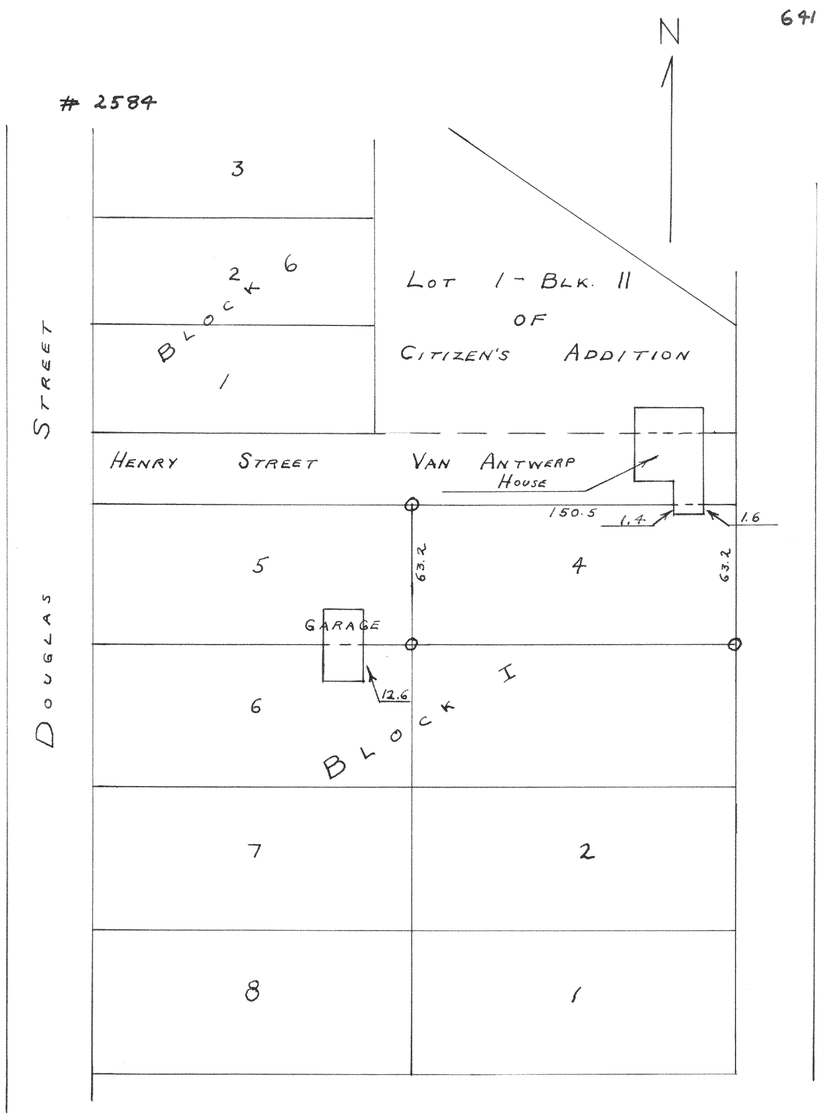

Plat Of Survey Of Lot 4 Of Block I Of Brigham's Addition And A Drawing Of The Remainder Of Block I And Part Of Block 6 Of Brigham's Addition And A Drawing Of Lot 1 Of Block II Of Citizen's Addition To The Village Of Sharon

July 1951

Lloyd L. Jensen SA
County Surveyor