
2587

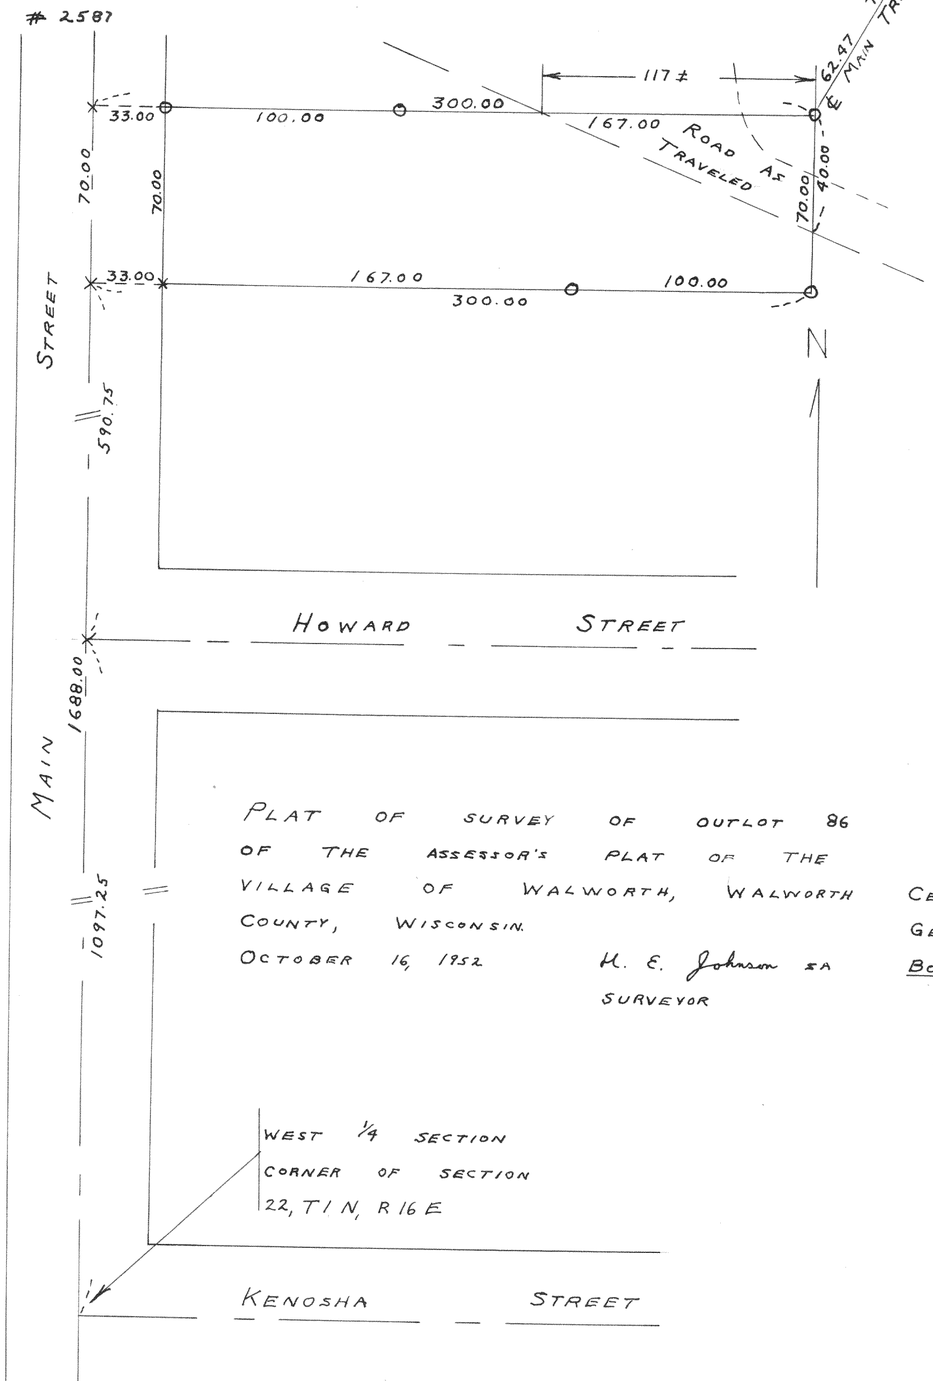


PLAT OF SURVEY OF OUTLOT 86 OF THE ASSESSOR'S PLAT OF THE VILLAGE OF WALWORTH, WALWORTH COUNTY, WISCONSIN.

OCTOBER 16, 1952

H. E. Johnsen SA
SURVEYOR

2588

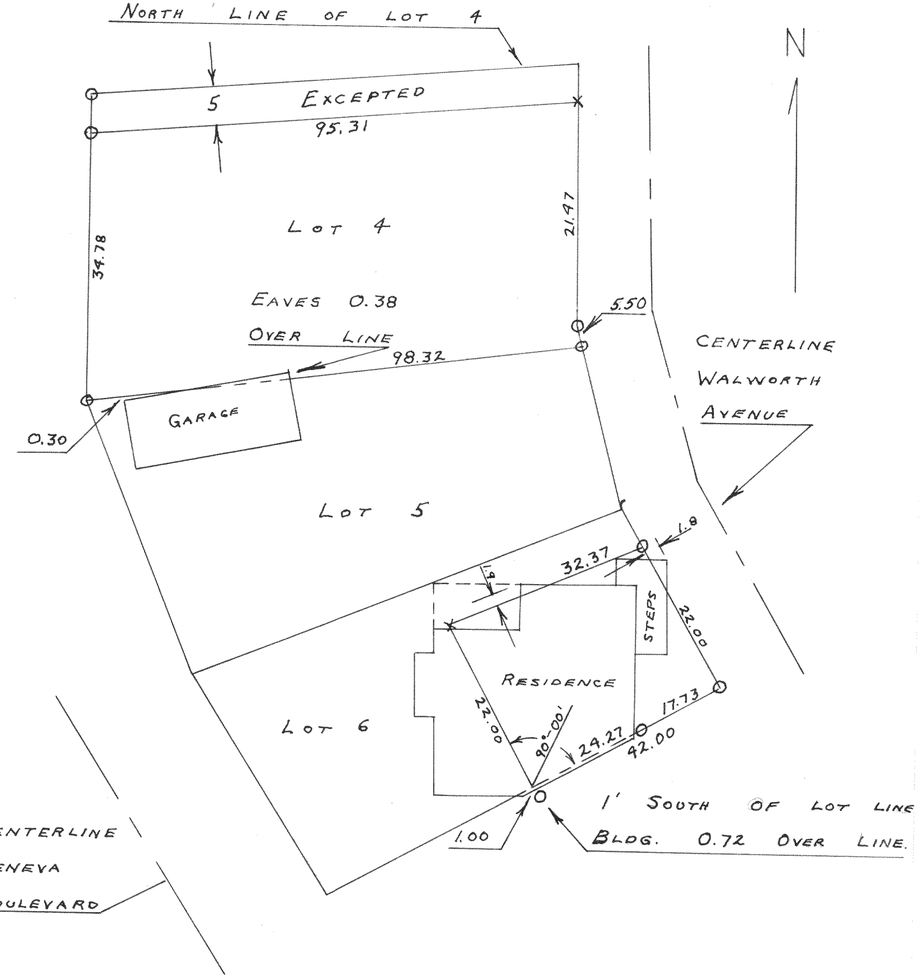

PLAT OF SURVEY OF PART OF LOT 4 AND PART OF LOT 6 BLOCK 7 OF GLENWOOD SPRINGS SUBDIVISION LOCATED IN THE VILLAGE OF FONTANA WALWORTH COUNTY, WISCONSIN.

APRIL 10, 1952

Lloyd L. Jensen SA
COUNTY SURVEYOR