
2593

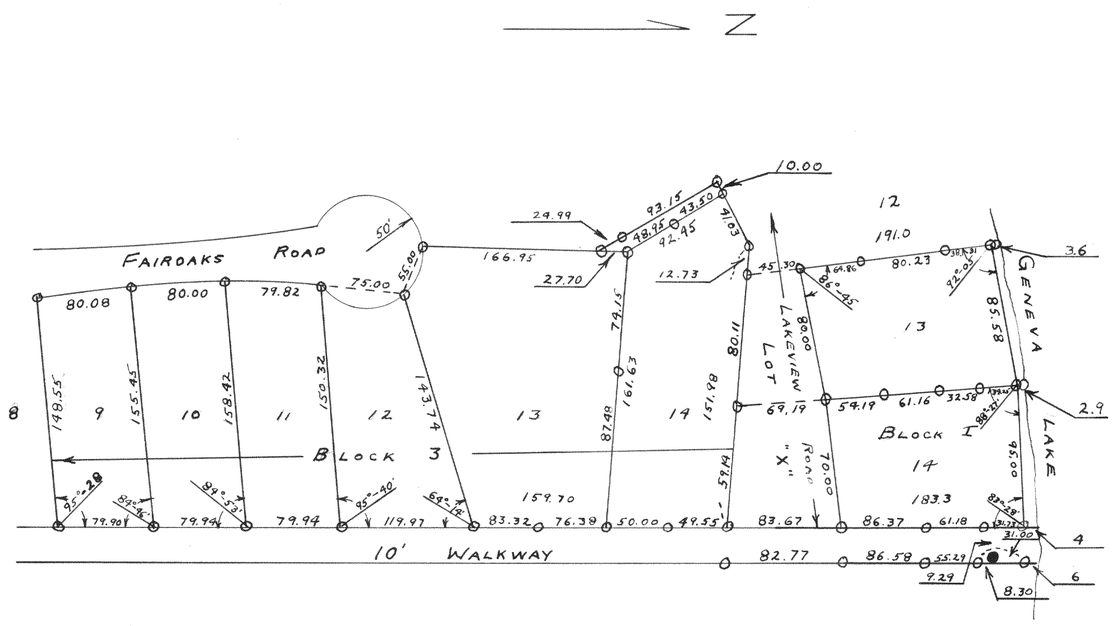


PLAT OF SURVEY OF LOTS 9 TO 14 INCLUSIVE, BLOCK 3 AND LOTS 13 AND 14, BLOCK 1 WOODDALE ADDITION, LOCATED IN SECTION 9, T1N, R17E OF WALWORTH COUNTY, WISCONSIN AND OTHER LAND.

MAY 1952

Lloyd L. Jensen SA
COUNTY SURVEYOR

2594

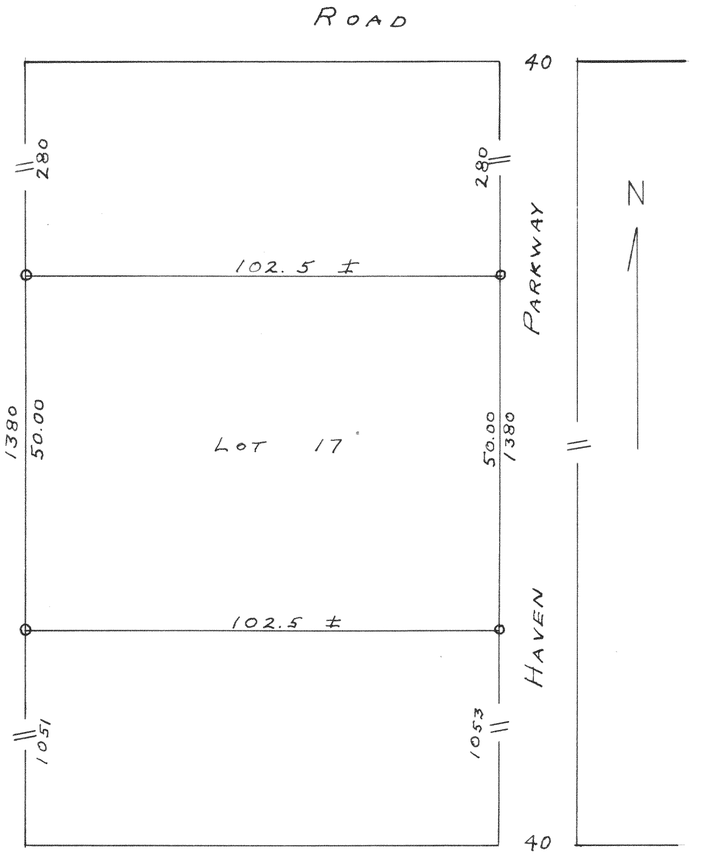

SOUTH SHORE DRIVE

PLAT OF SURVEY OF LOT 17 SHORE HAVEN SUBDIVISION LOCATED IN SECTION 18, T1N, R17E OF WALWORTH COUNTY, WISCONSIN.

SEPTEMBER 1952

Lloyd L. Jensen SA
COUNTY SURVEYOR