
2611

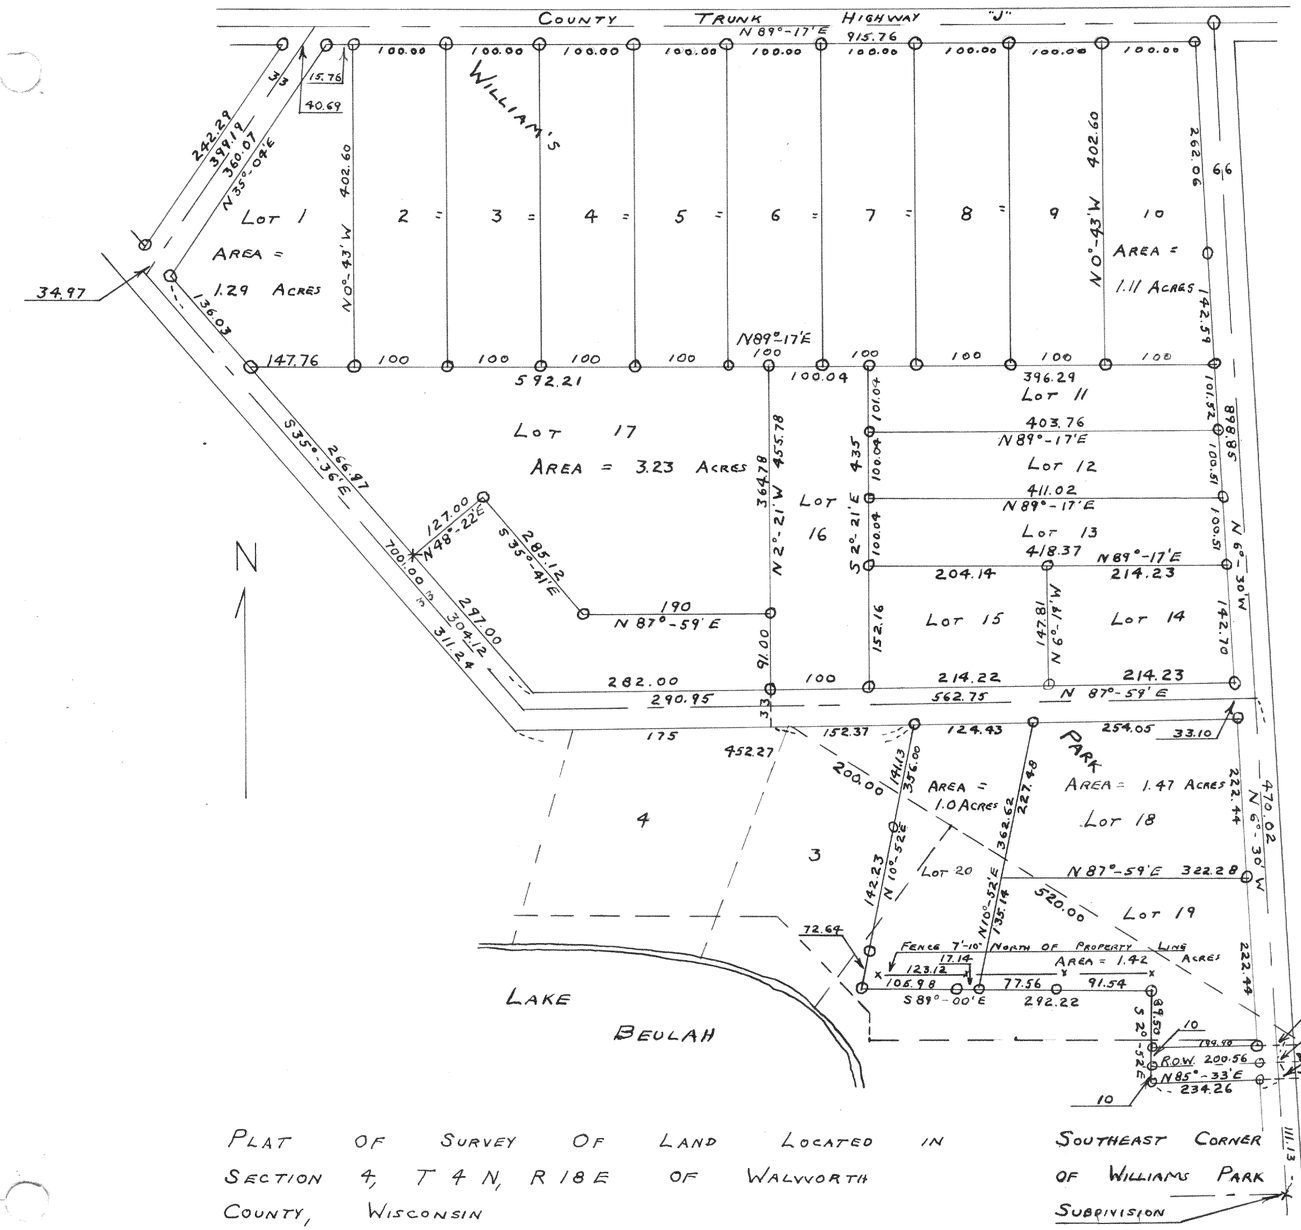


PLAT OF SURVEY OF LAND LOCATED IN SECTION 4, T 4 N, R 18 E OF WALWORTH COUNTY, WISCONSIN

OCTOBER 1952

Lloyd R. Jensen SA
COUNTY SURVEYOR

SOUTHEAST CORNER OF WILLIAMS PARK SUBDIVISION

2612

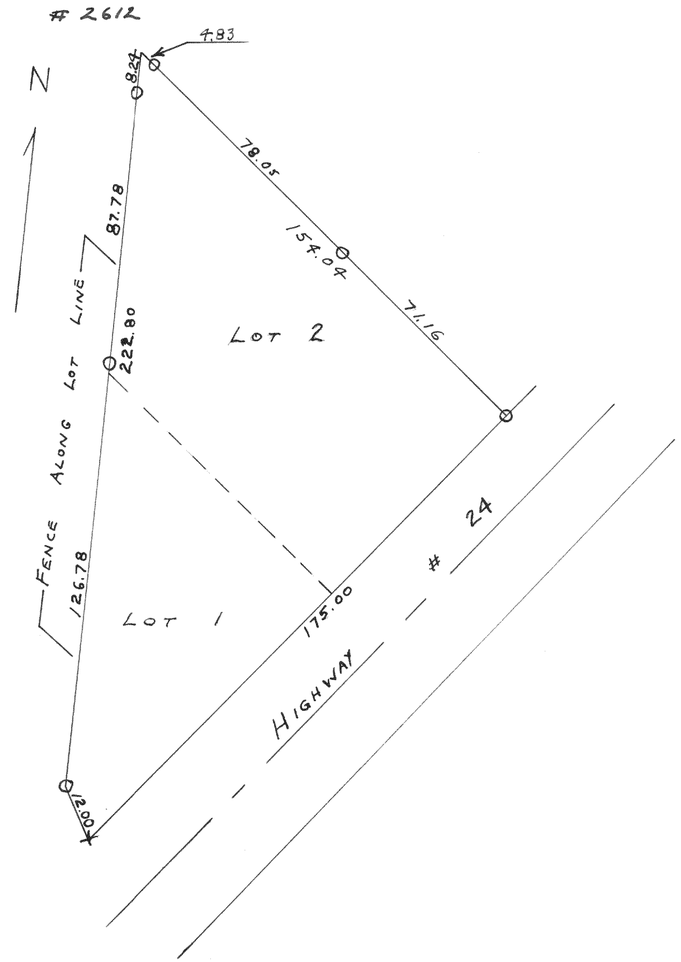

PLAT OF A SURVEY OF LOTS 1 AND 2 OF BLOCK I OF THE ORIGINAL PLAT OF LAKE BEULAH WALWORTH COUNTY, WISCONSIN.

AUGUST 1952

Lloyd R. Jensen SA
COUNTY SURVEYOR