
#1301

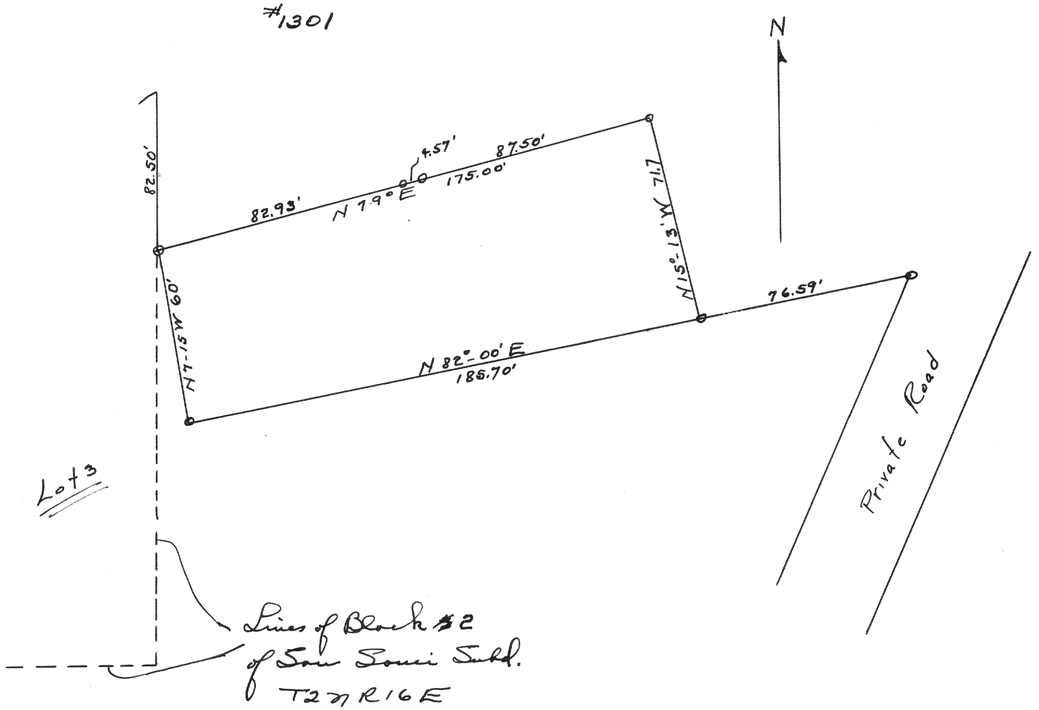


Plat of survey of land purchased by Mrs. Lillian Anderson in 1942.

Aug. 1942

Lloyd L. Jensen
County Surveyor

#1302

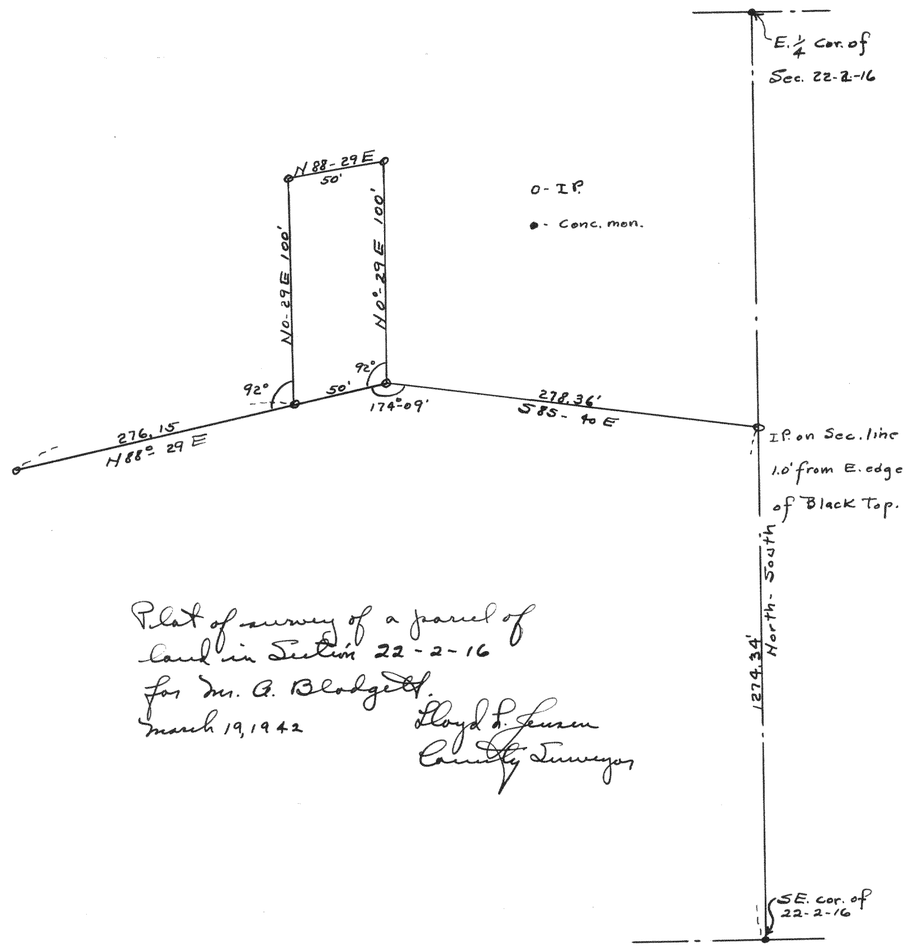

Plat of survey of a parcel of land in Section 22-2-16 for Mr. A. Blodgett.

March 19, 1942

Lloyd L. Jensen
County Surveyor