

SURVEY No. 1198

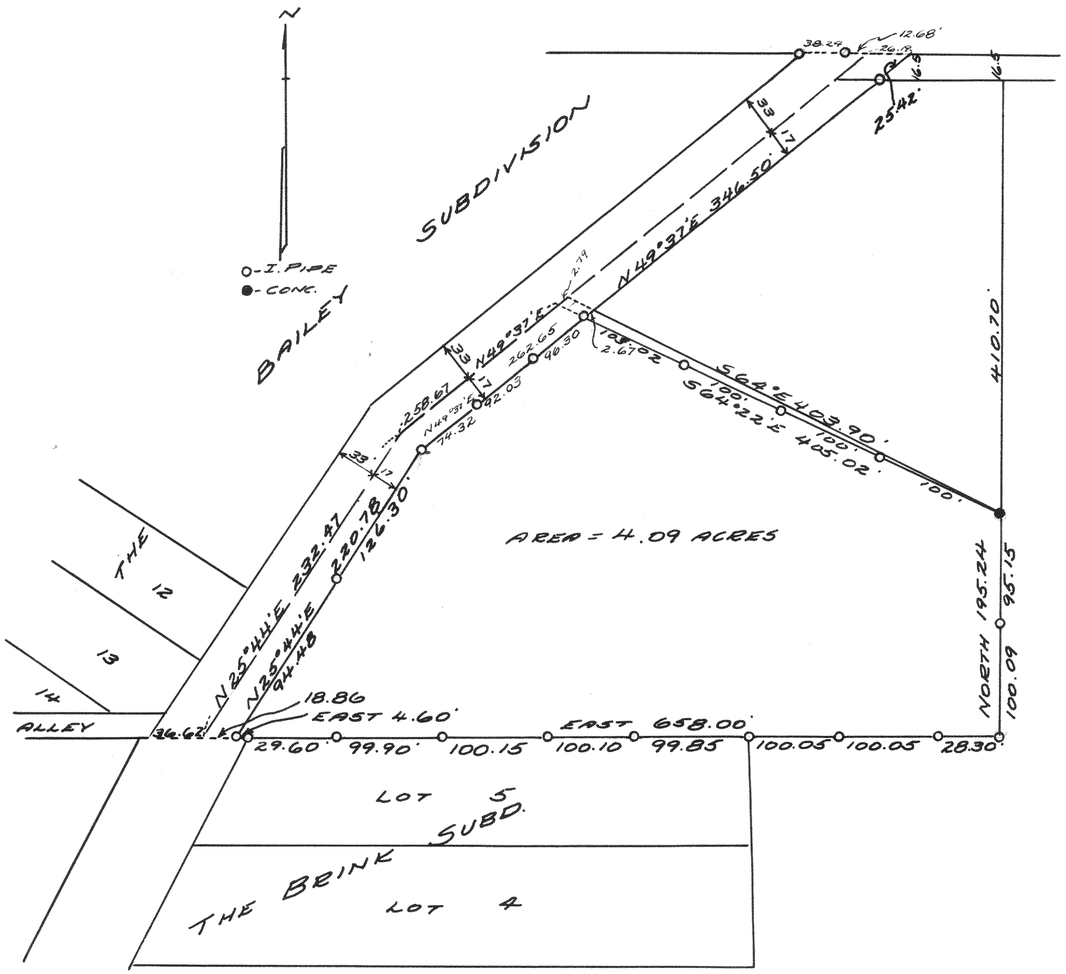

PLAT OF SURVEY OF LAND LOCATED IN THE WEST FR. ½ OF SECTION 27, T2N R16E, WALWORTH CO., WISC.
DEC., 1941

Lloyd L Jensen
C.E.

SURVEY No. 1199

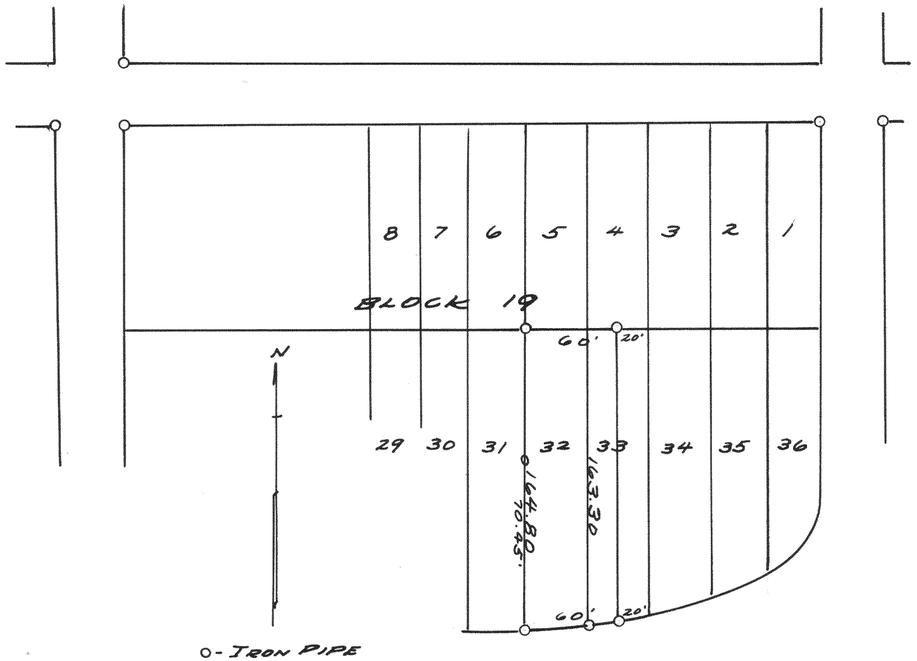

PLAT OF SURVEY OF LOT 32 AND THE WEST ½ OF LOT 33, BLOCK 19, DELAVAN LAKE VIEW CREST SUBD., WALWORTH COUNTY, WISCONSIN.
NOV. 26, 1941

Lloyd L Jensen
C.E.